


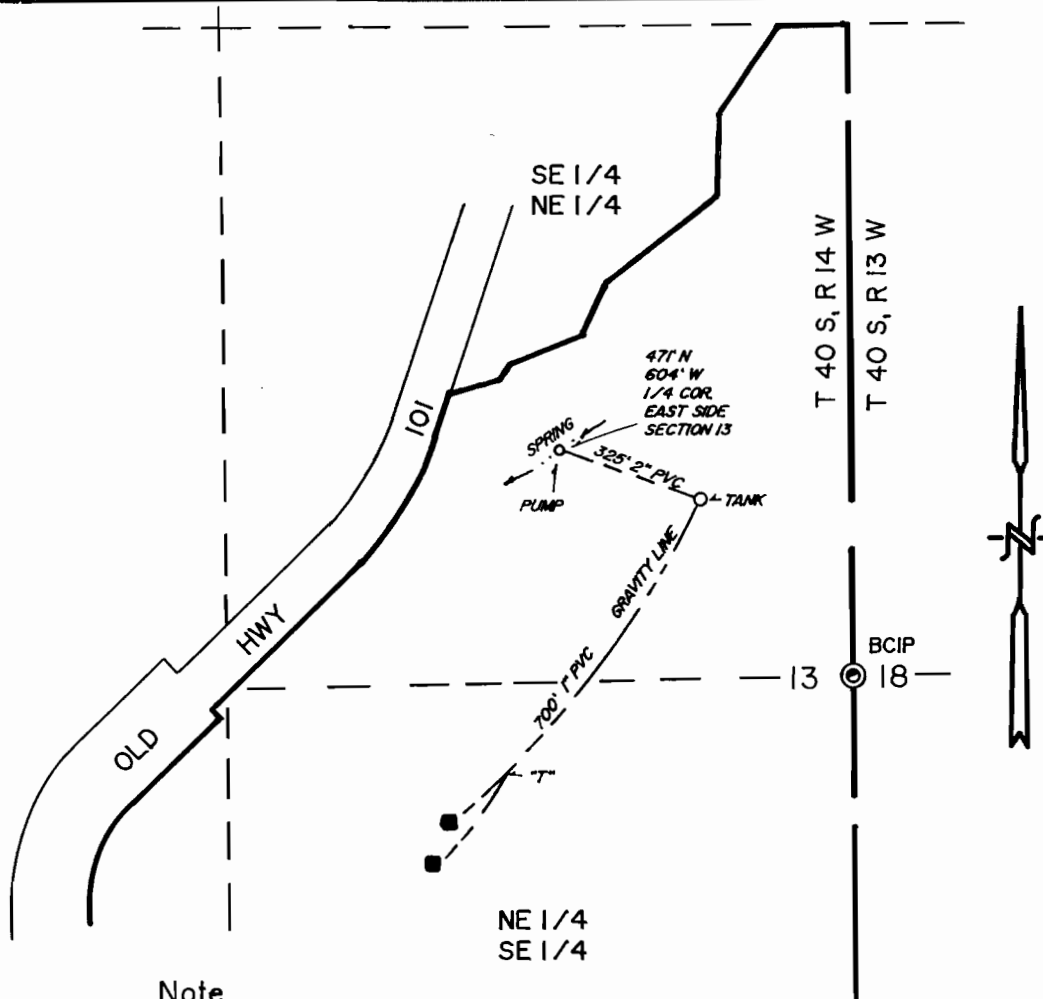

**T 40 S., R 14 W., W.M.
SECTION 13**

FINAL PROOF SURVEY

UNDER

Application # 71318 Permit # 51205

in the name of

**LOIS L. TETLEY (Deceased) by
Attorney in fact, Cathleen B. Herbage**

Surveyed March 24, 1992, by H.J. Newhouse

Scale 1" = 400'

