



G-5283
47958

SHENANDOAH ESTATES

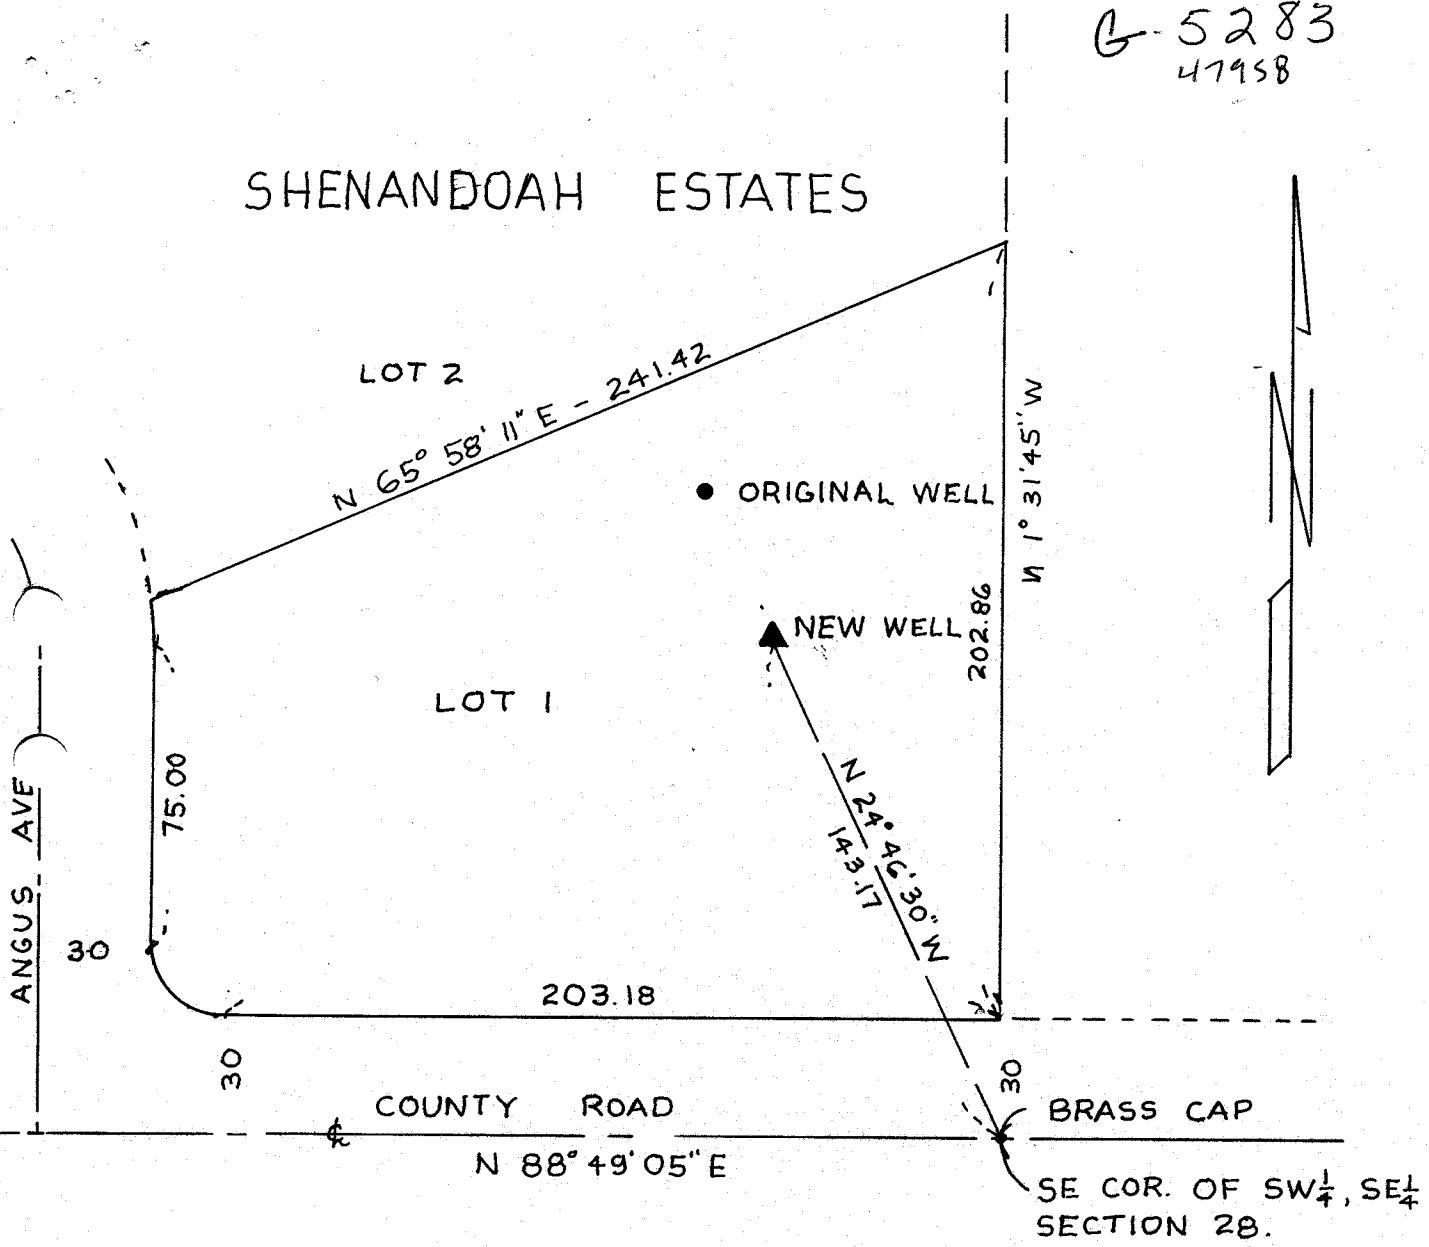

 KRUMBEIN ENGINEERING LTD. ENGINEERS - SURVEYORS - PLANNERS 361 S.E. Second Pendleton, Oregon	Scale 1" = 50'	Drn. By DHK	Drng. No. 9213A	Revision 1
	Date 11-29-92	Ckd. By	Job No. 8917	Revision 2
FINAL PROOF MAP HERITAGE IMPROVEMENT DISTRICT SEC. 28, T. 2 N., R. 33. E. W. M.	