


T.30 & 31 S. R. 6 W. W.M.

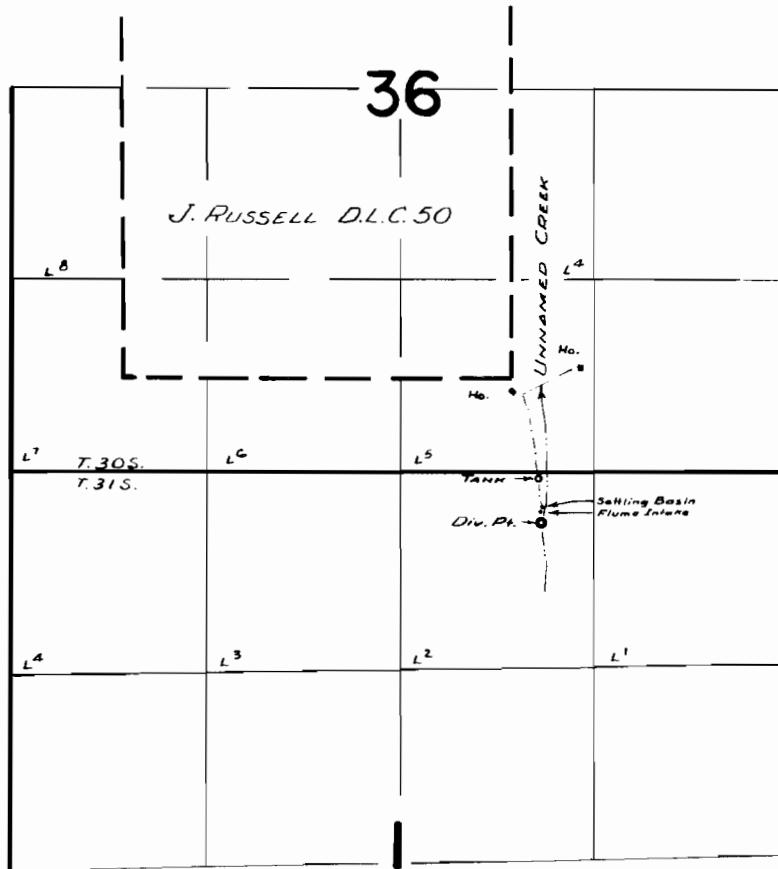

Note: Location of Ho's from applicants map

FINAL PROOF SURVEY UNDER

Application No. 34379 Permit No. 27055
IN NAME OF

WILLIAM IVAN RUSSELL

Surveyed 5 MAY 1961, by *Wm. Bish*