

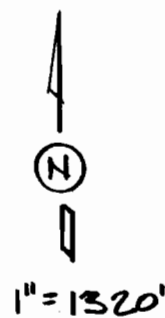


# SECTION 2 & 3, T.15., R.3W., W.M.

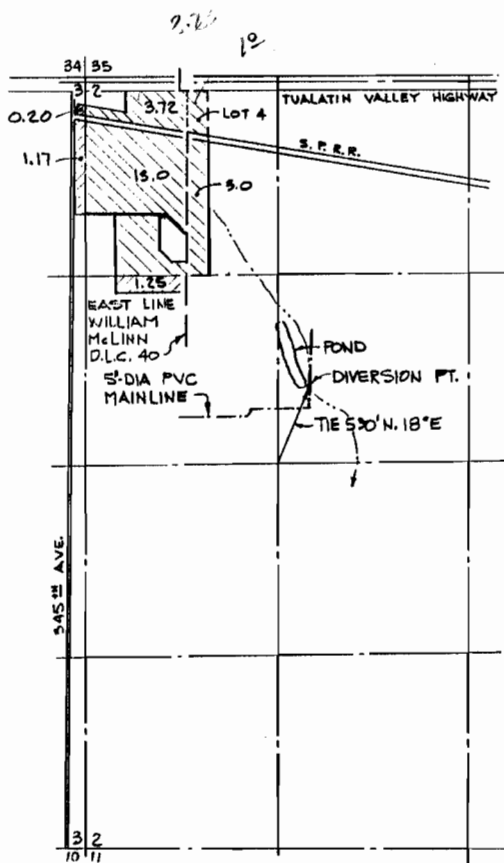

PREPARATION OF THIS MAP IS FOR THE PURPOSE OF IDENTIFYING THE LOCATION OF THE WATER RIGHT ONLY. THERE IS NO INTENT TO PROVIDE DIMENSIONS OR LOCATION OF PROPERTY OWNERSHIP LINES.

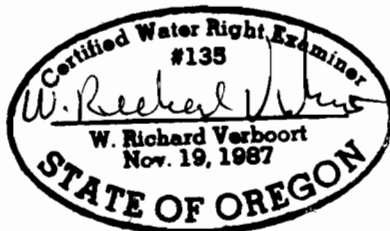

## FINAL PROOF SURVEY UNDER

APPLICATION No. 69610 PERMIT No. 50740

SURVEYED JULY 3, 1991

REVISED 01-26-92

**VERBOORT ENGINEERING**  
AGRICULTURE • CIVIL • WATER RESOURCES  
HILLSBORO, OREGON

	by	date
designed	WRV	7.7.91
drawn	JER	7.7.91
checked	WRV	7.7.91
drawing no.	91-A-11	
sheet no.	1/1	

**EDMUND DUYCK**  
2020 S.W. 325 TH  
HILLSBORO, OR 97123