


T. 5 S. R. 1 E. W. M.

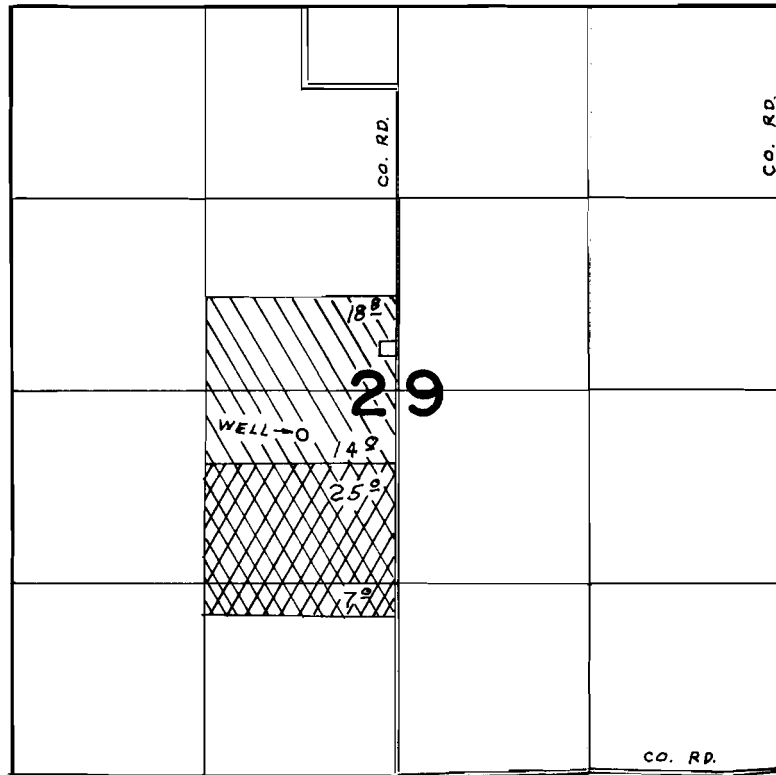

WELL LOC. 310'S & 640'W. FROM CENTER SEC. 29

FINAL PROOF SURVEY
UNDER

Application No. G-4354 Permit No. G-4109
IN NAME OF

Clark Hickman

Surveyed NOV 6 1974, by L.H. NUNN