


T. 4N. R. 27E. W.M.

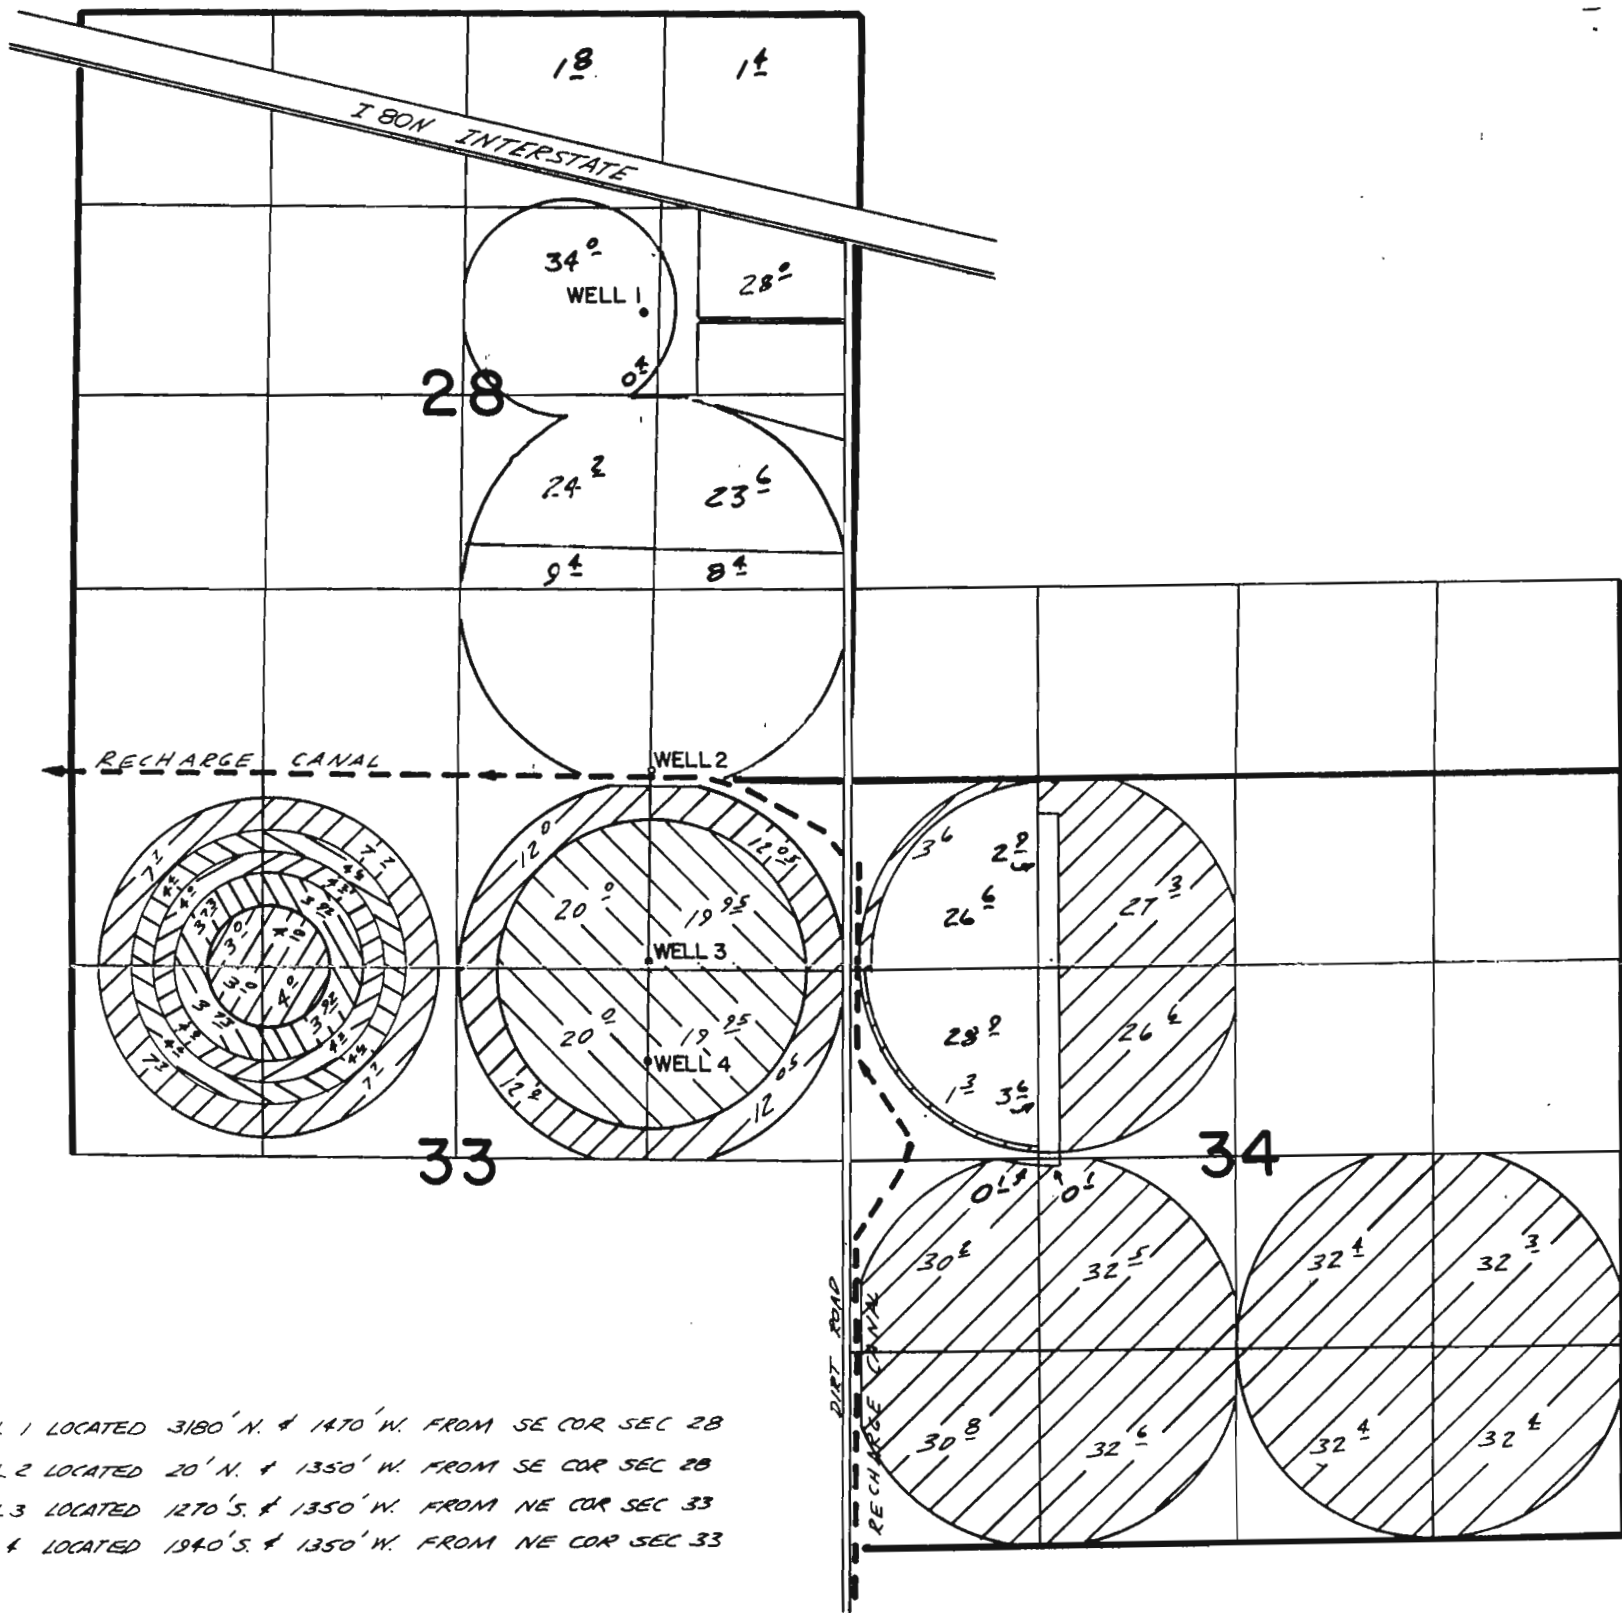

WELL 1 LOCATED 3180' N. & 1470' W. FROM SE COR SEC 28
 WELL 2 LOCATED 20' N. & 1350' W. FROM SE COR SEC 28
 WELL 3 LOCATED 1270' S. & 1350' W. FROM NE COR SEC 33
 WELL 4 LOCATED 1940' S. & 1350' W. FROM NE COR SEC 33

FINAL PROOF SURVEY
 UNDER

APPL. G-2831 PER. G-2822
 TRANSFERS

3902 3903 3904
 3905 4089

IN NAME OF

12H, INC.

SURVEYED 8-2 1978, BY R. BARWIN



PER G-2822



T-3902



T-3903



T-3904



T-3905



T-4089