


T. 4 N. R. 27 E. W. M.

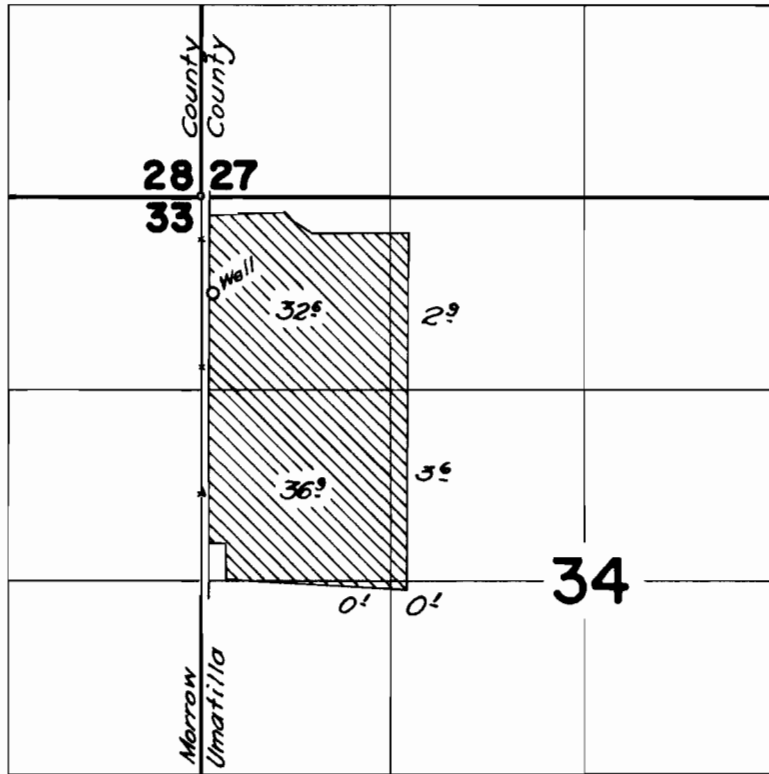

FINAL PROOF SURVEY
UNDER

Application No. G-1222.. Permit No. G-1069..
IN NAME OF

.....MARVIN M. MCDOLE.....

Surveyed Oct. 3, 1961., by *R. Jackson*