


FINAL PROOF SURVEY
SEC. 16, T1S, R3W, W.M., WASHINGTON COUNTY, OR
FOR
ORCHARD VIEW NURSERY

CORNELIUS, OR 97113

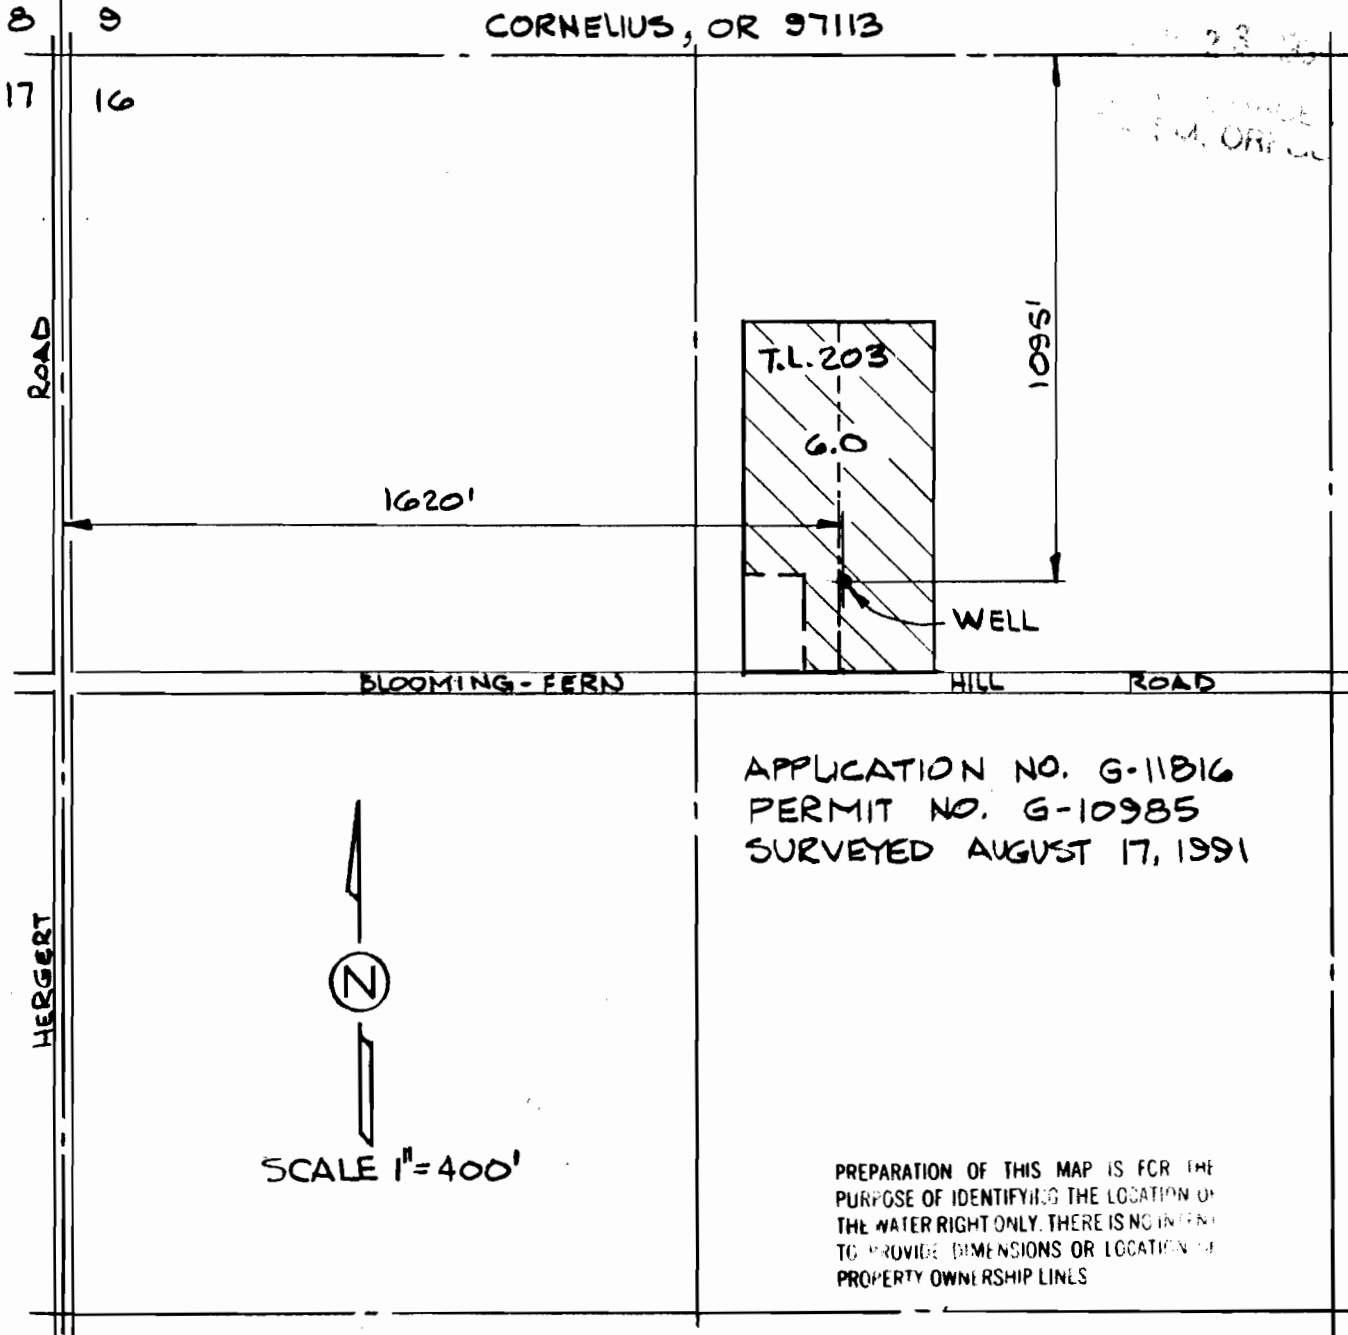

PREPARED BY:
W. RICHARD VERBOORT, P.E.
DRAWING NO. 91-A-15

