


W-472

27978
68716
76224
76225

T.26 S.R.14 E.W.M.

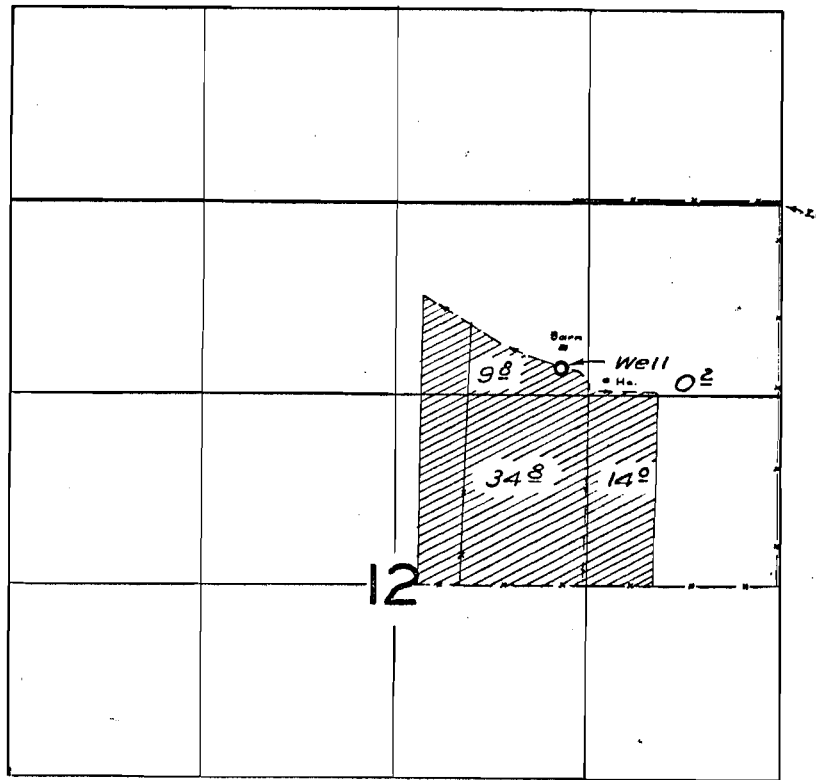

T-# 3510

FINAL PROOF SURVEY UNDER

Application No. U-517 Permit No. U-472
IN NAME OF

Bud Baert

Surveyed 12 May 1959, by m. B. B.

2-1852