


T26S, R3W, WM

SCALE 1" = 1320'

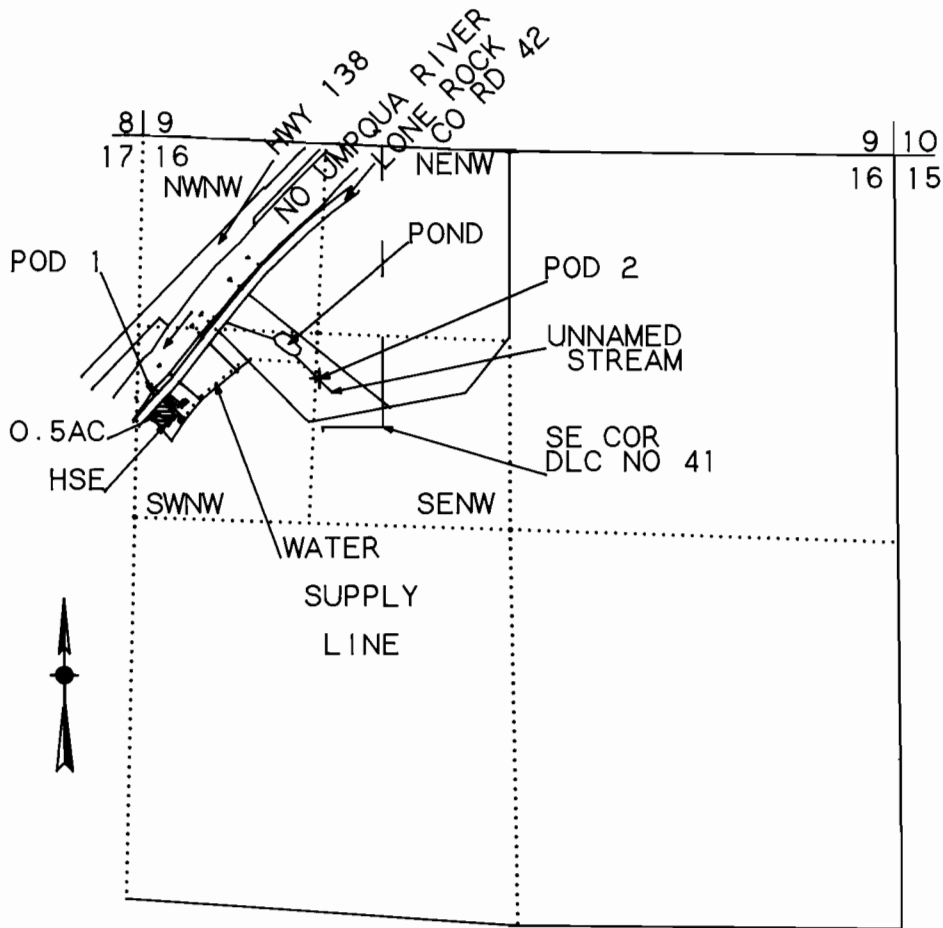

POD 1 1770 FT S AND 60 FT E FROM NW COR SEC 16

POD 2 1670 FT S AND 1210 FT E FROM NW COR SEC 16

FINAL PROOF SURVEY

UNDER

Application No. 70628 Permit No. 51258

IN NAME OF

CHARLES K. RIDENOUR

Surveyed June 22, 1992 by M E Farr

