


T. 4 S., R. 5 S., W.M.

Located: SE 1/4, SE 1/4 Section 27, T. 4 S.,
R. 5 W., WM, Yamhill County, Oregon
Yamhill County tax lot 4527- 100
Norm Barnett tract (Film volume
226 Page 1908, Yamhill Co deed records)

Date: 03 May 1993

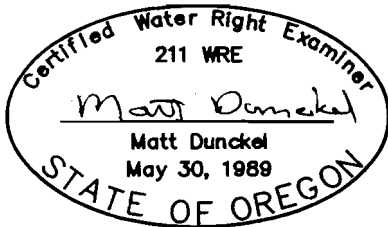

By: Matt Dunckel & Assoc.
19010 Baker Creek Road
McMinnville, OR 97128
Phone: 472-7904


RECEIVED

MAY 14 1993

WATER RESOURCES DEPT.
SALEM, OREGON

North

Scale: 1" = 400'

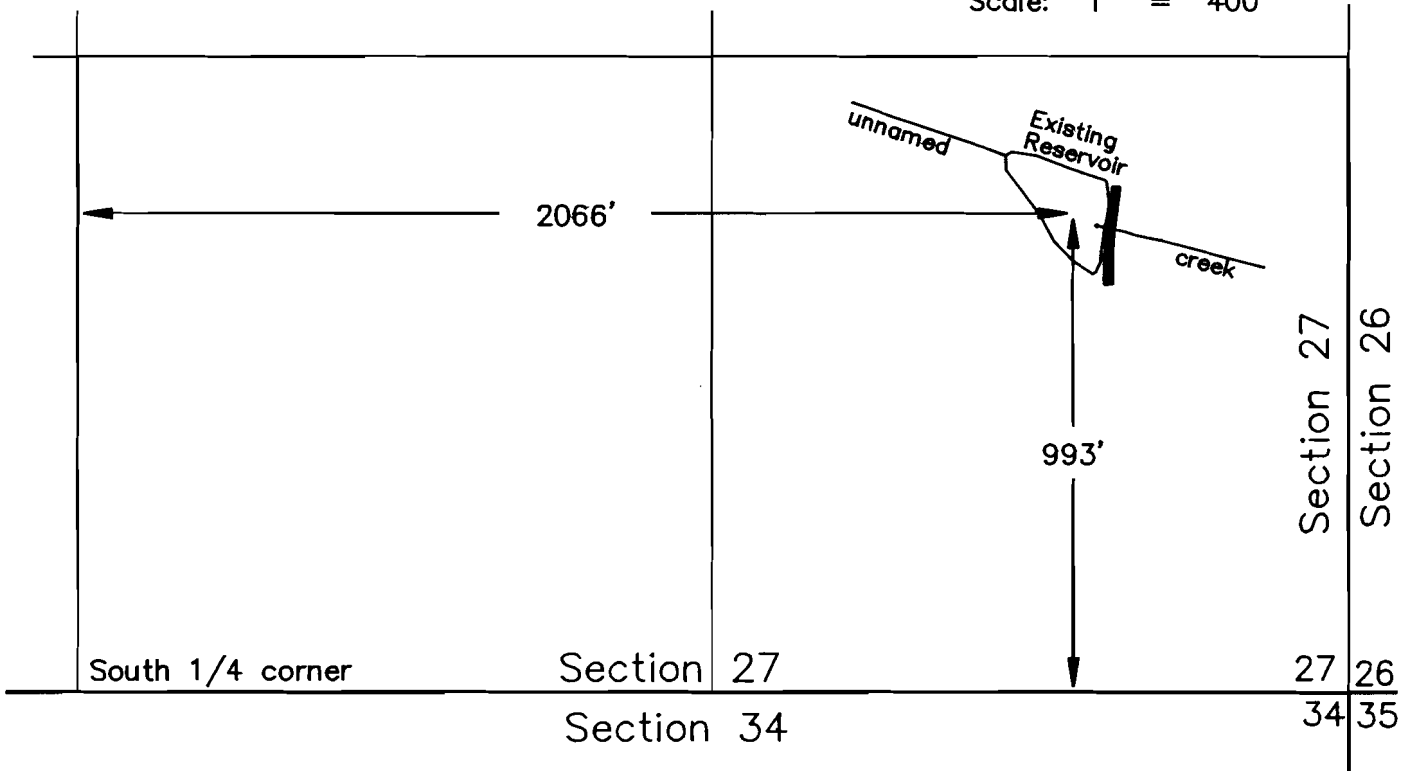

FINAL PROOF SURVEY
UNDER

Application No. R-71325 Permit No. R-11388

IN NAME OF

NORMAN L. BARNETT &
NORMAN L. BARNETT TRUST

Surveyed January 8, 1992,