


T. 4 S., R. 5 S., W.M.

Located: NE 1/4, SE 1/4 Section 27, &
NW 1/4, SE 1/4 Section 27, T. 4 S.,
R. 5 W., WM, Yamhill County, Oregon
Yamhill County tax lot 4527- 100
Norm Barnett tract (Film volume
226 Page 1908, Yamhill Co deed records)


Scale: 1" = 400'

Date: 03 Oct. 1993

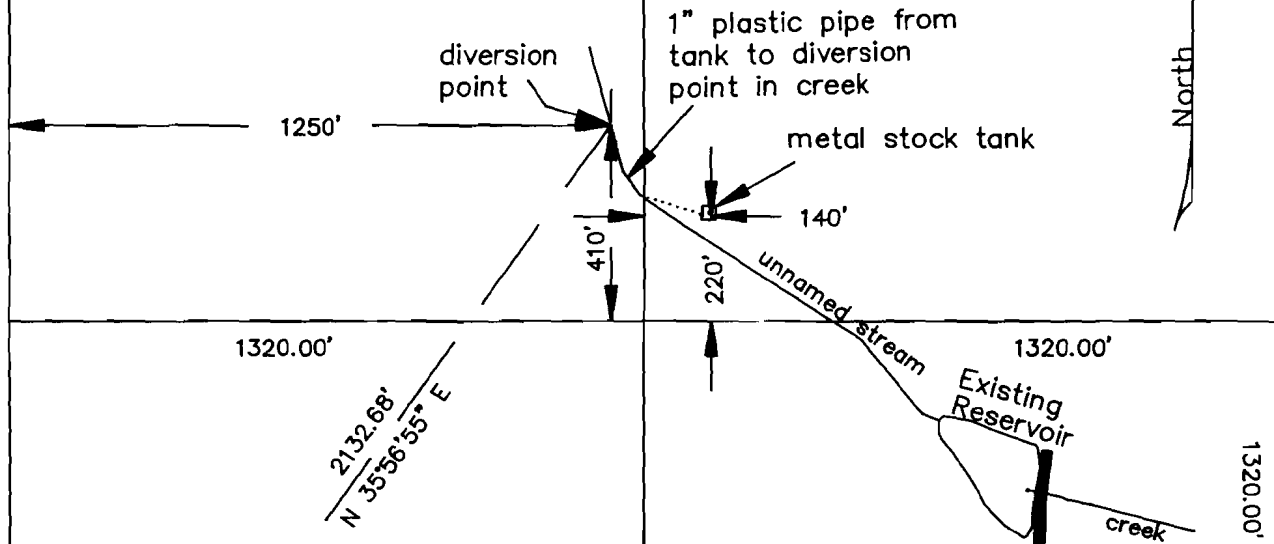

I certify that the information I have provided
in this Final Proof is an accurate
representation of the permitted water use and is
true and correct to the best of my knowledge.
This map is to be used for the purpose of identifying
the location of water right only and is not
intended to provide legal dimensions or
locations of property ownership lines.

Matt Dunckel, CWRE

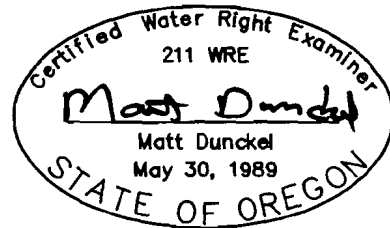

By: Matt Dunckel & Assoc.
19010 Baker Creek Road
McMinnville, OR 97128
Phone: 472-7904

South 1/4 corner
3/4" IP w/ 2" brass cap

Section 27

Section 34

Section 27
Section 26

27 26
34 35

FINAL PROOF SURVEY UNDER

Application No. 71326 Permit No. 51270

IN NAME OF

NORMAN L. BARNETT &
NORMAN L. BARNETT TRUST

Surveyed October 3, 1993,