

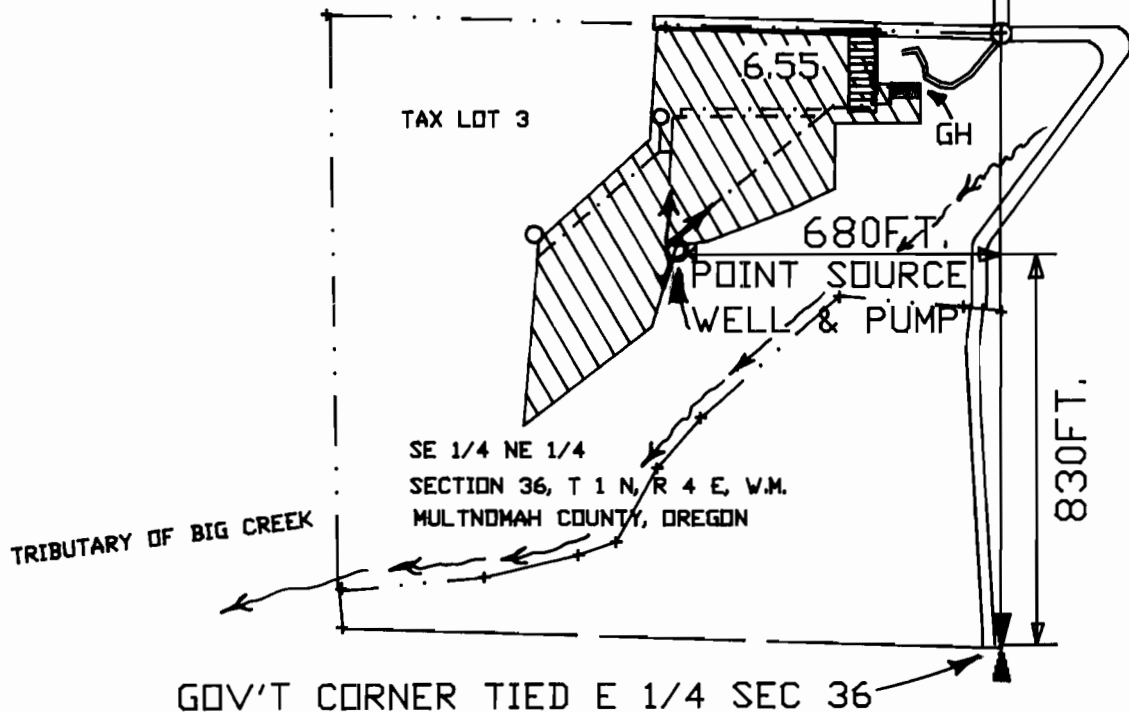


- LEGEND**
-  DISTRIBUTION LINE
 -  WELL
 -  PERENNIAL STREAM
 -  HOSE BIBB
 -  CONTAINER NURSERY
 -  GH GREENHOUSE
 -  RELATED NURSERY

SCALE: 1"=400'

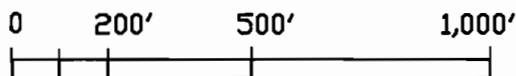

THIS MAP IS PREPARED ONLY FOR USE IN IDENTIFYING THE PROPOSED WATER RIGHT. NO USE FOR LOCATING PROPERTY OWNERSHIP BOUNDARY LINES IS INTENDED.

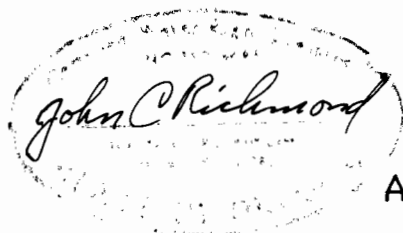

FINAL PROOF SURVEY

UNDER

APPLICATION No. G-11757, PERMIT No. G-10881

IN NAME OF

C.N. & B.D. KLOCK

SURVEYED: SEPT. 1991 BY: J. RICHMOND