

Water Rights Map


Final Proof Survey

Permit no. G-12187

Application no. G-11315

NE 1/4 SE 1/4, NW 1/4 SE 1/4

Section 28 Township 28S Range 14W W.M.

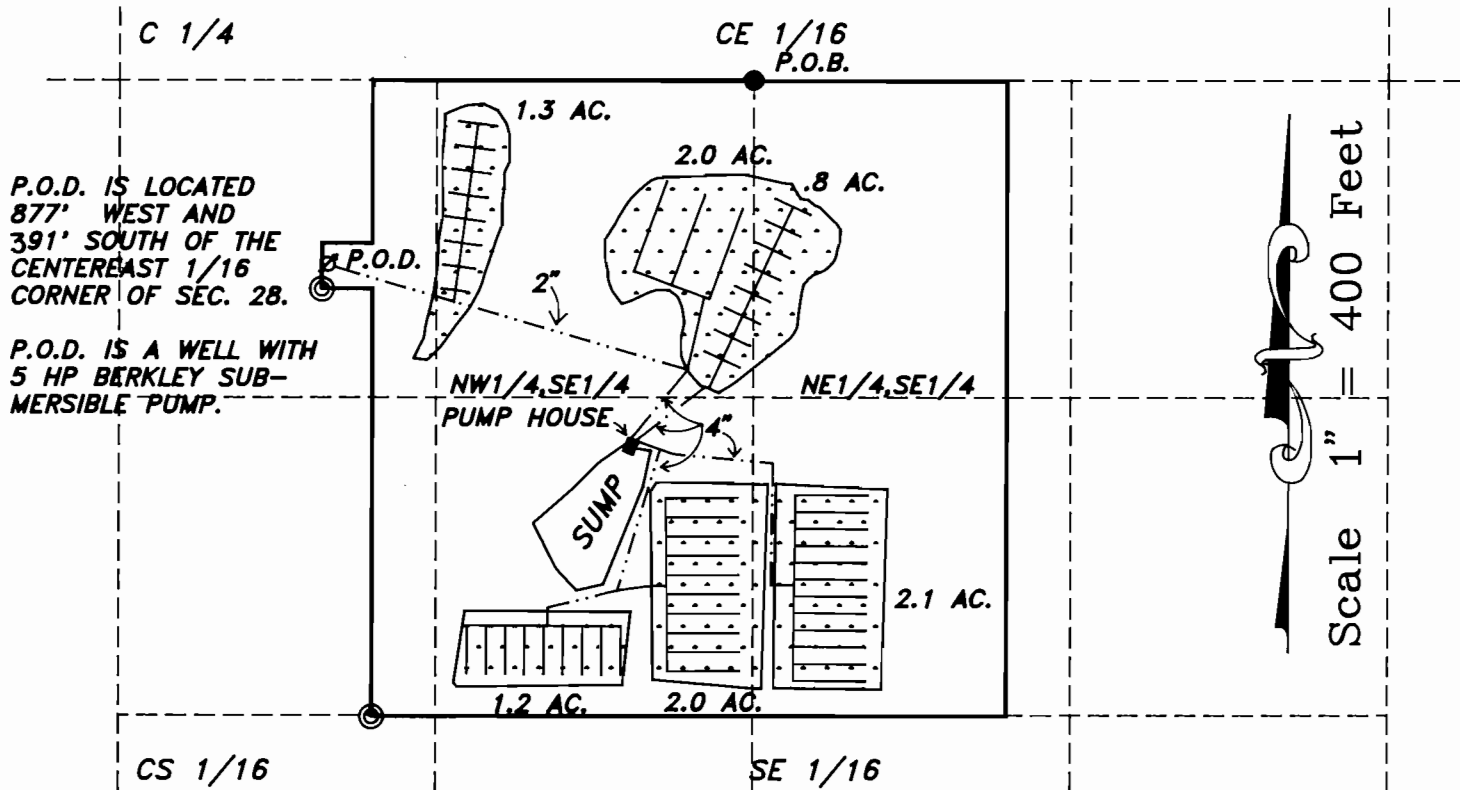

LEGEND:

- ⊙ FD. MONUMENTS
- ⊘ POINT OF DIVERSION
- POINT OF BEGINNING.
- PROPERTY LINE.
- PIPE
- PIPE IN BOGS.
- ▭ IRRIGATED AREA.
- PUMP HOUSE.

NOTE:

LATERAL LINES IN THE BOGS ARE 3", 2", 1 1/4", AND 1".

DATE SURVEYED: 17 JAN. 1994

PREPARED FOR: GANCRAN

PERPARED BY: D. GOUDE

K. CLEVINGER

EXAMINERS DISCLAIMER STATEMENT

The preparation of this map was for the purpose of identifying the location of the Water Right only and has no intent to provide dimensions or location of property ownership lines.

Stuntzner Engineering & Forestry

705 So. 4th Street
P.O. Box 118
Coos Bay, Oregon 97420

Phone (503) 267-2872
Fax (503) 267-0588

