


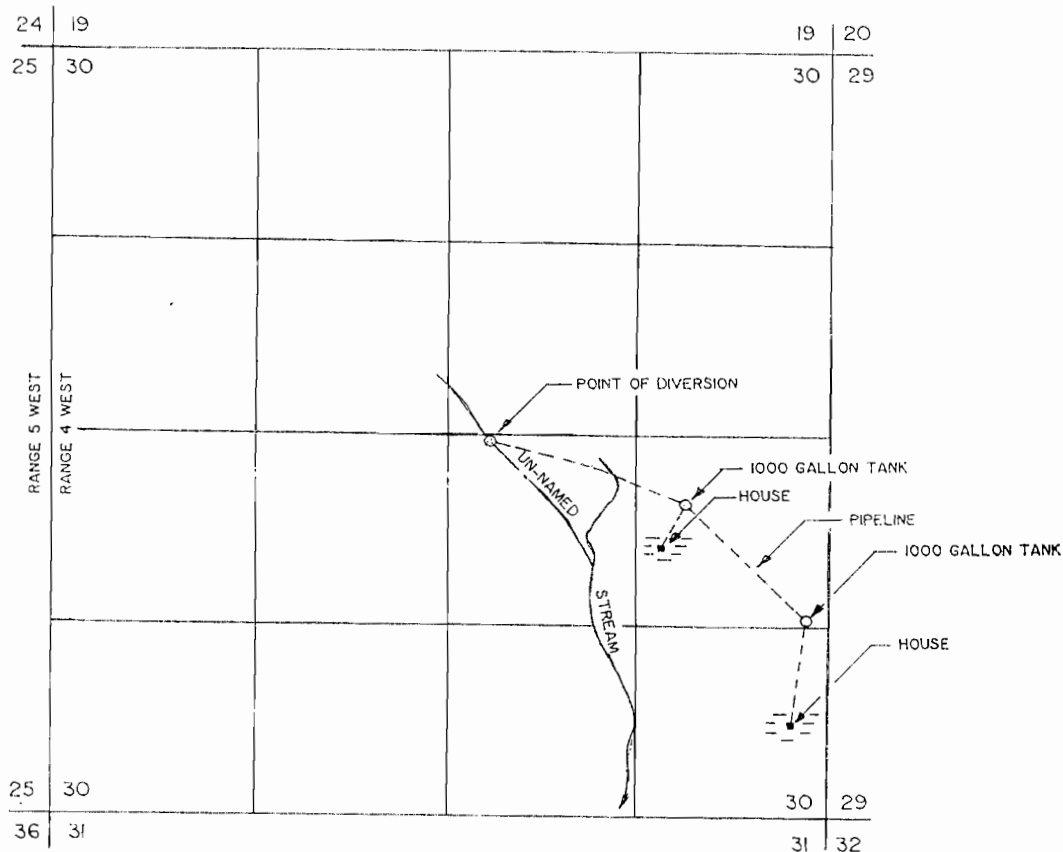

1 INCH = 1320 FEET


FINAL PROOF SURVEY MAP IN THE NAME OF APRIL I. ANDERSON

SECTION 30, T23S, R4W, W.M.



THE POINT OF DIVERSION IS LOCATED 2620 FEET NORTH
AND 2390 FEET WEST FROM THE SOUTHEAST CORNER OF SECTION 30,
BEING WITHIN THE NW 1/4 OF THE SE 1/4 OF SECTION 30, TOWNSHIP
23 SOUTH, RANGE 4 WEST, W.M., DOUGLAS COUNTY.

THE PURPOSE OF THIS MAP IS TO IDENTIFY THE LOCATION OF
THE WATER RIGHT. IT IS NOT INTENDED TO PROVIDE INFOR-
MATION RELATIVE TO THE LOCATION OF PROPERTY OWNERSHIP
BOUNDARY LINES.

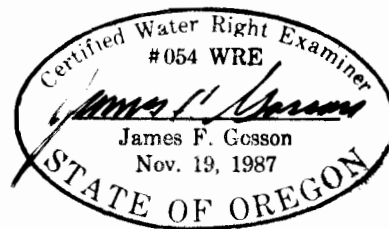

P 50275