


# T. 22S, R. 8W., W.M.

1 INCH = 1320 FEET

W BNDY  
DLC No 51

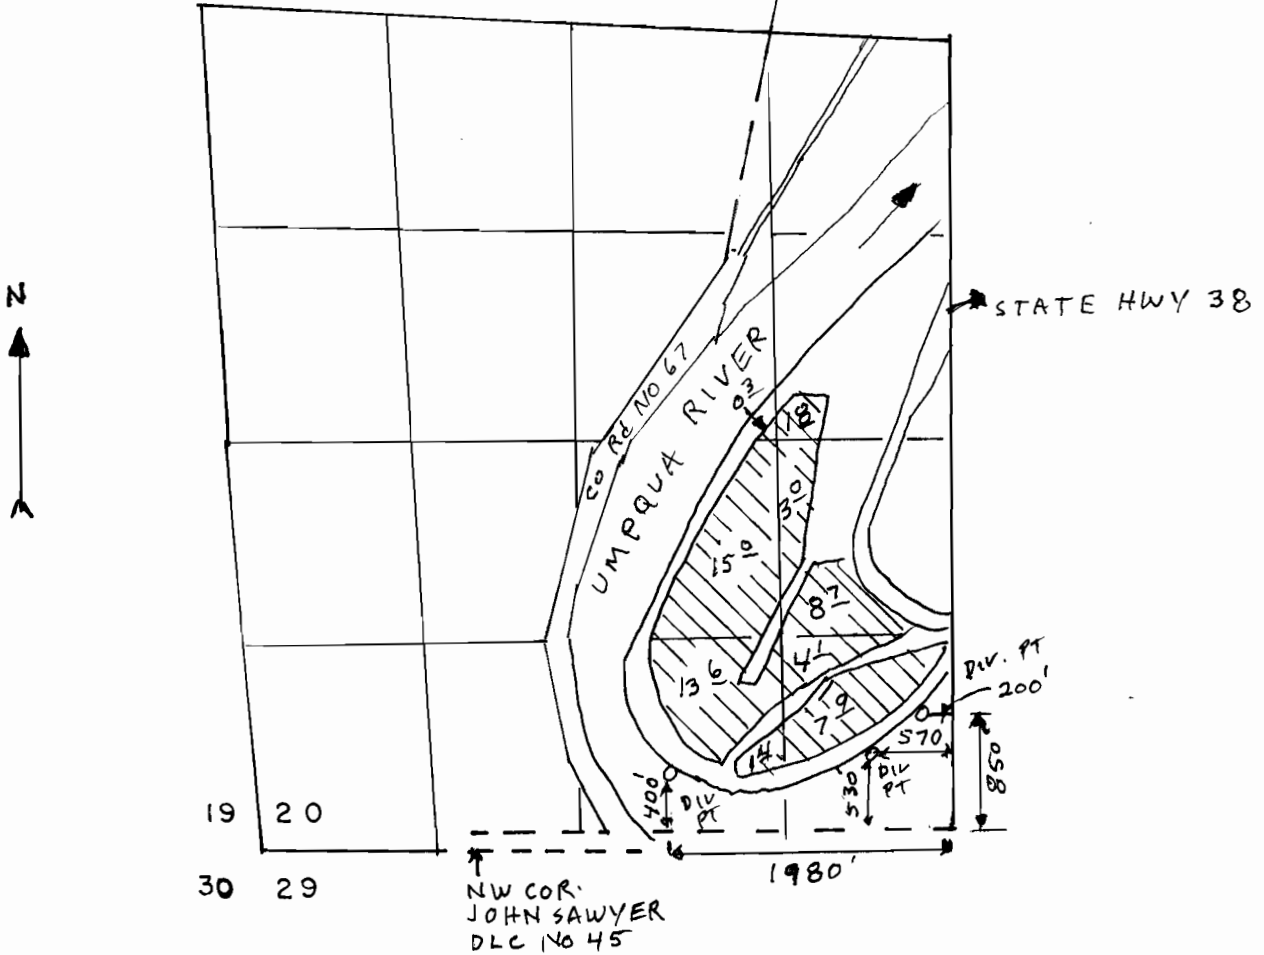

## FINAL PROOF SURVEY

UNDER

THE PURPOSE OF THIS MAP IS TO IDENTIFY THE LOCATION OF THE WATER RIGHT. IT IS NOT INTENDED TO PROVIDE INFORMATION RELATIVE TO THE LOCATION OF PROPERTY OWNERSHIP BOUNDARY LINES.

Application No. 70501 Permit No. 51070  
IN NAME OF

STEPHEN C. TRDUT

Surveyed MAR 5 1995 by DUANE KIRBY

