
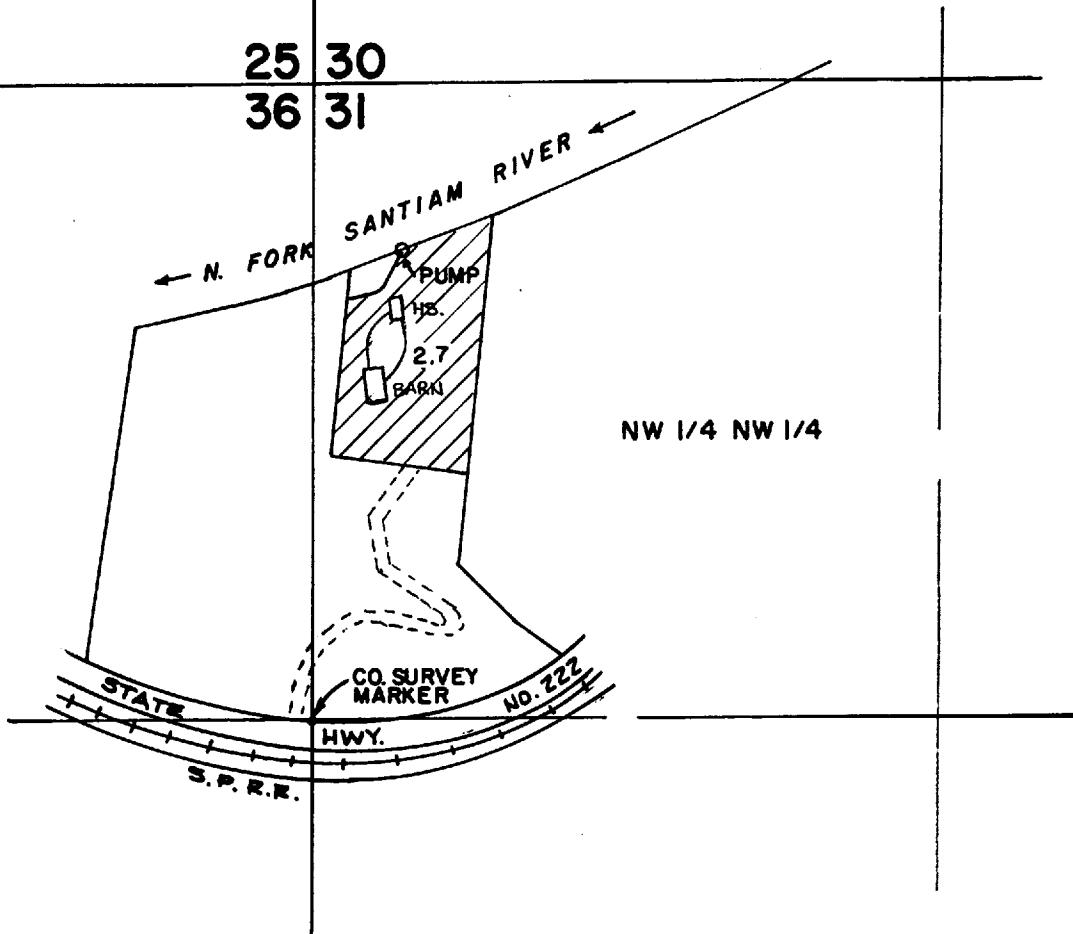


T.9S.R.2E.W.M.

T.9S. R.3 E. W.M.

25 30
36 31

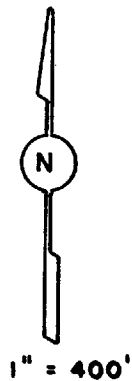


WATER RIGHT MAP FOR

JAMES L. GIROD

SURVEYED ON AUG. 30, 1991

RECEIVED
SEP 18 1991

BY

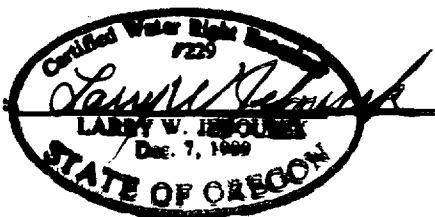

PUMP FROM N. SANTIAM RIVER LOC. 350' S. & 180' E FROM SEC. COR. 25, 30, 31, 36