
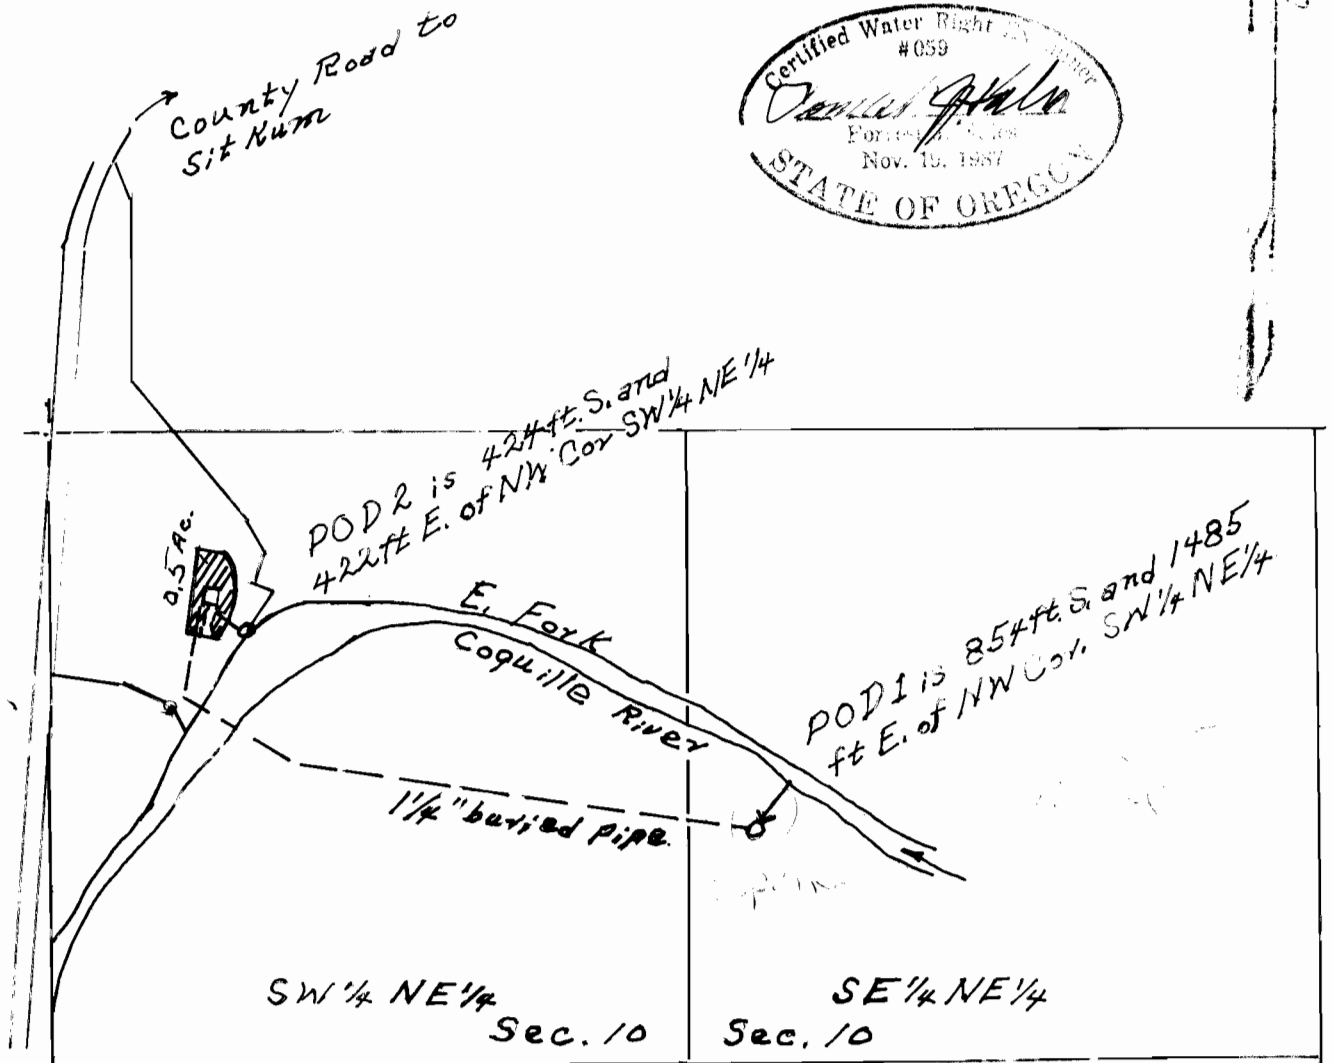


T. 28 S., R. 11 W. W. M.  
FINAL PROOF SURVEY

Scale: 1" = 400ft.

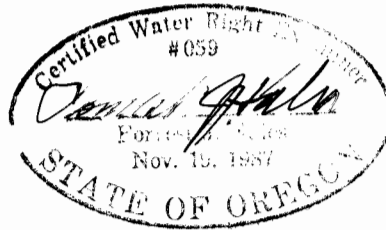

Application No. 70669

Permit No. 51153

In Name of Brian W. and Diana K. Laird

Surveyed Dec. 7, 1991 by Forrest J. Hales