


T. 4 N. R. 28 E. W. M.

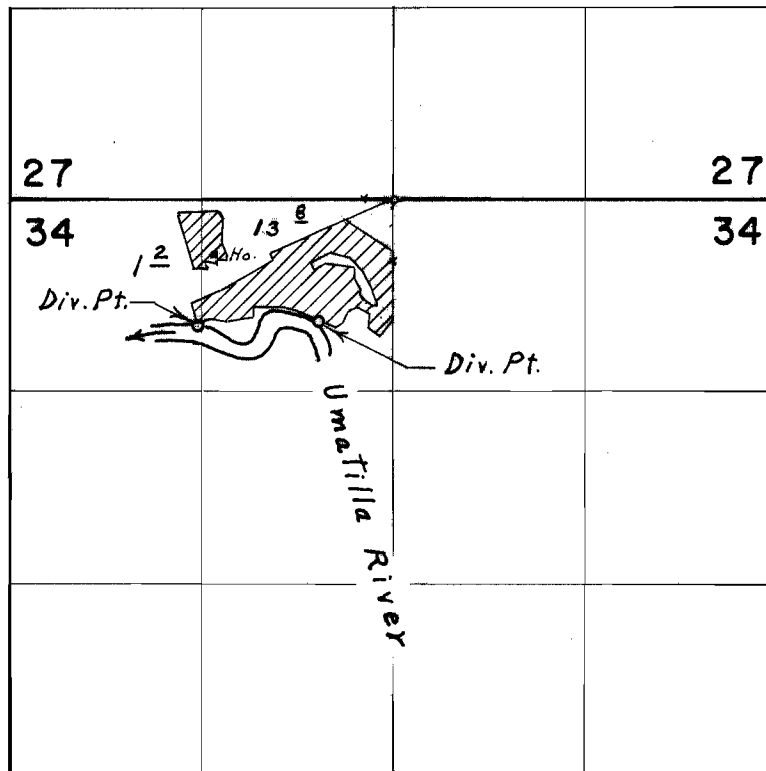

Div. Pts. located; 830' S. & 010' W., 870' S. & 1840' W. both from N. $\frac{1}{4}$ Cor. Sec. 34

FINAL PROOF SURVEY UNDER

Application No. 43651 Permit No. 32631
IN NAME OF

THEODORE ISZLER

Surveyed July 2, 1971, by L. E. Gould