


T.3N.R.29E.W.M.

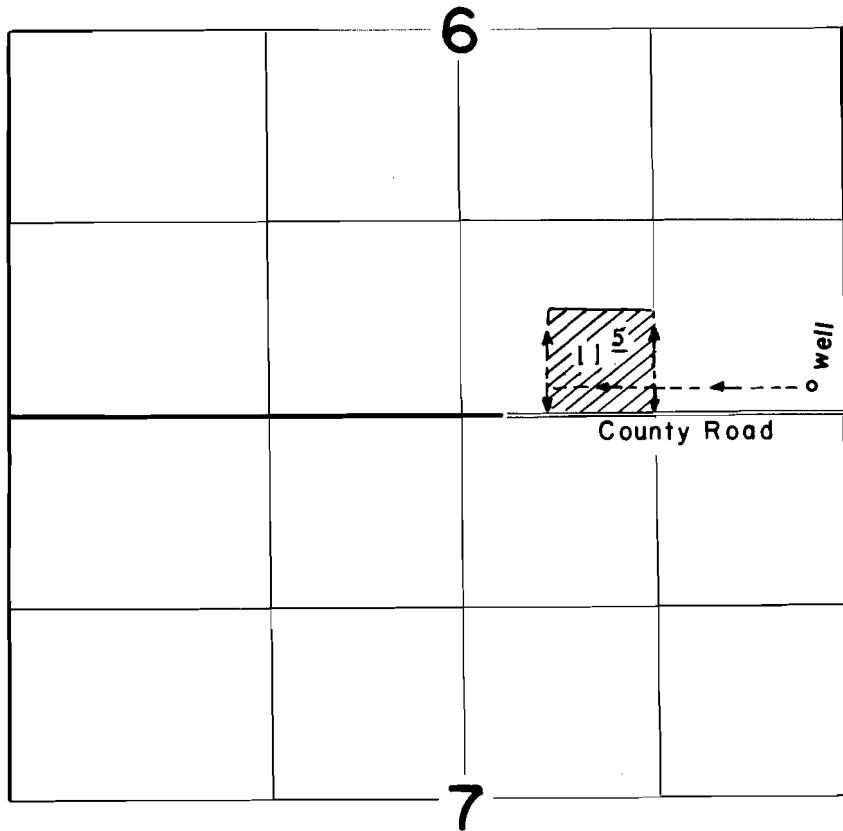

FINAL PROOF SURVEY
UNDER

Application No. G-2013... Permit No. G-1854...
IN NAME OF

J. F. Riley

Surveyed Aug. 20 1964, by C. J. Gardner...