

# FINAL PROOF MAP


T4S, R3W, W.M.  
SECTION 19

18 17  
19 20



SCALE: 1" = 400 FEET  
NW

NE

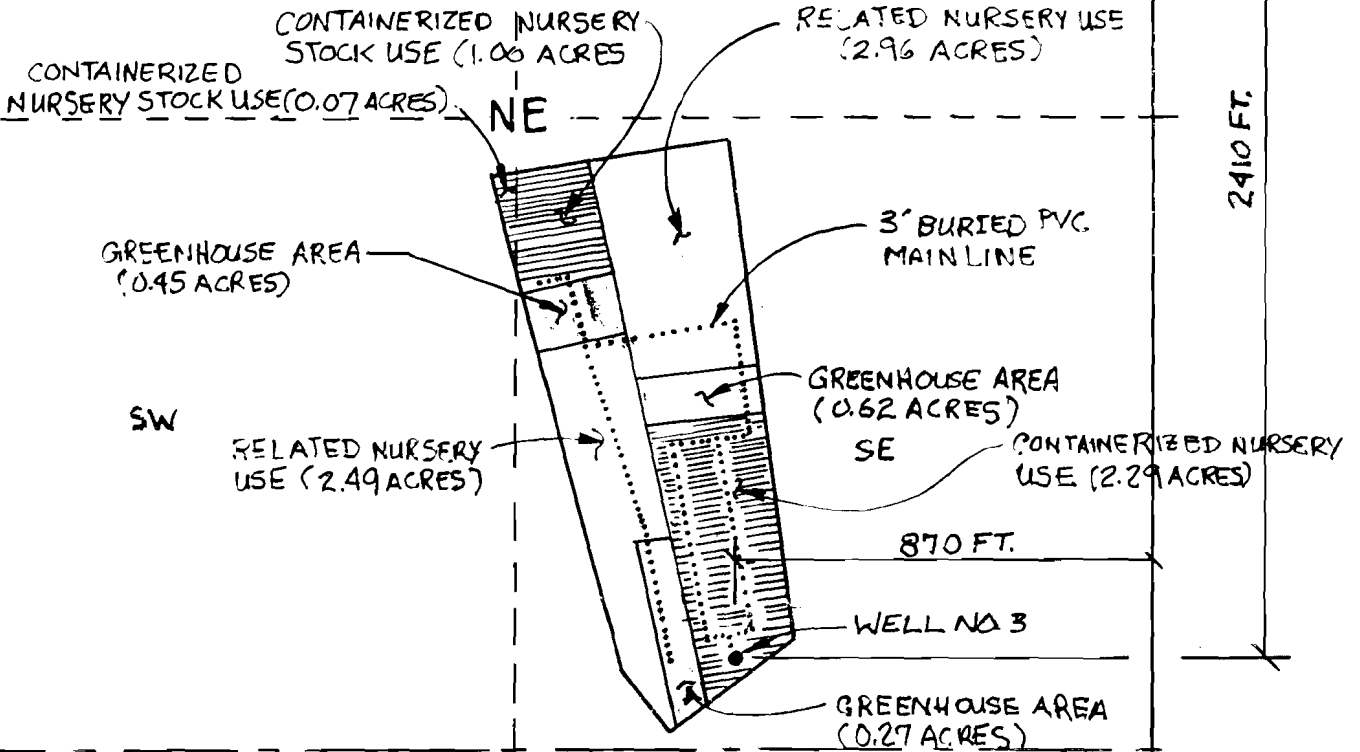

PERMIT No. G10797

