


ORIGINAL
RECEIVED

T.30S.,R.20E.,W.M.

MAY 15 1996

WATER RESOURCES DEPT.
SALEM, OREGON

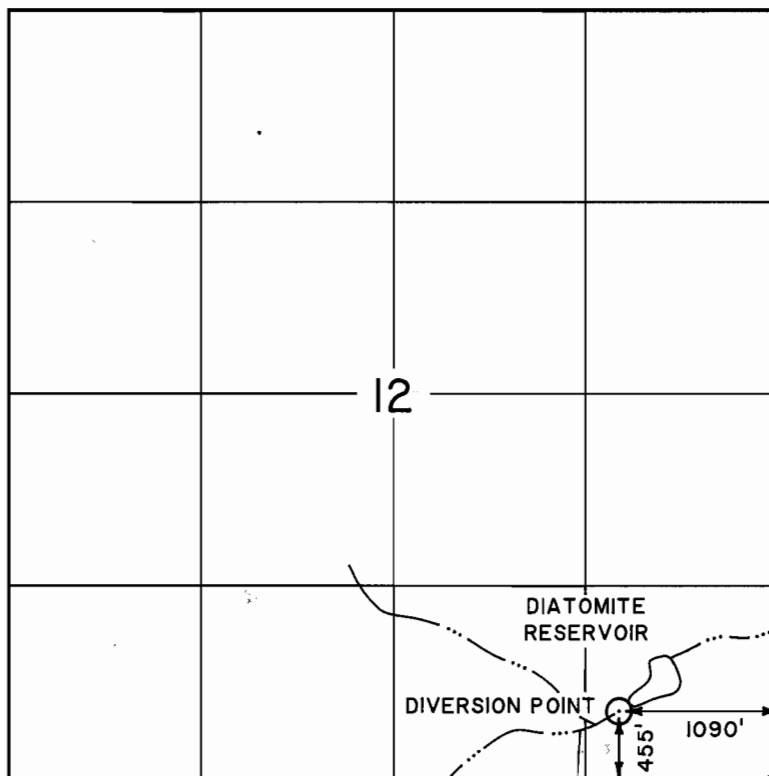

1" = 1320'

FINAL PROOF MAP
UNDER



APPLICATION NO. R-47650 PERMIT NO. R-7391

IN NAME OF
UNITED STATES BUREAU OF LAND MANAGEMENT

SURVEYED JULY 19, 1994

THE PURPOSE OF THIS MAP IS FOR IDENTIFYING THE LOCATION OF THE WATER RIGHT ONLY AND
IS NOT INTENDED TO PROVIDE LEGAL DIMENSIONS OR LOCATION OF PROPERTY OWNERSHIP LINES.

THE TIE WAS DETERMINED BY INVERSE BETWEEN POSITIONS, DERIVED FROM A RESOURCE GRADE GLOBE POSITIONING
SYSTEM, A TRIMBLE PATHFINDER, WITH A POSITIONAL ACCURACY OF 2-5 METERS, 50 PERCENT OF THE TIME.

WRE 6138F OREGON

U.S. BUREAU OF LAND MANAGEMENT-OSO
BRANCH OF CADASTRAL SURVEY
LETTER OF AUTHORIZATION
DATED: MAY 9, 1994

EXECUTED BY:
RICHARD L. JOHNSON, PLS, CWRE
P.O. BOX 2965
PORTLAND, OREGON 97208

R.F.B.-1/10/96