
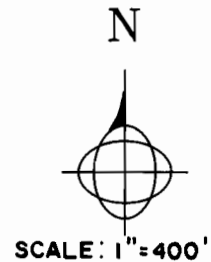


T.37S.,R.6W.,W.M.  
SECTION 15

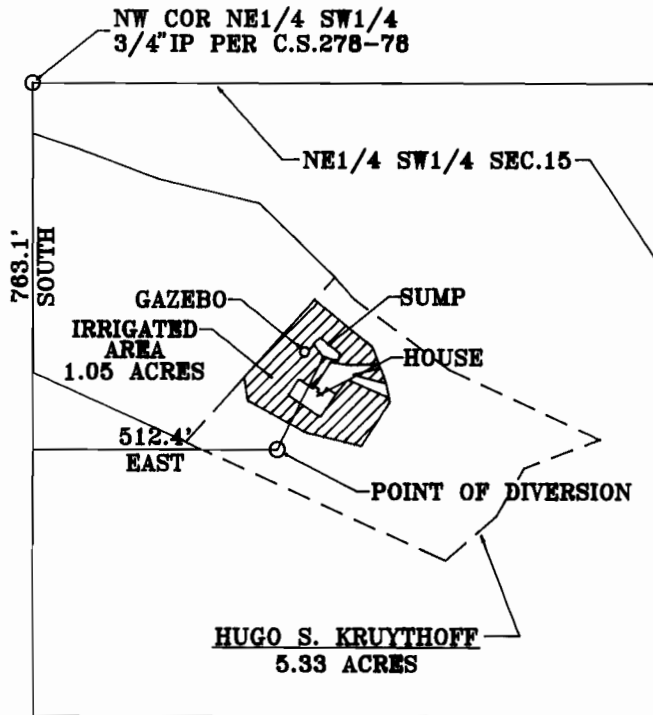

FINAL PROOF SURVEY  
UNDER

Application No.69123, Permit No.50073  
IN NAME OF

HUGO S. KRUYTHOFF

Surveyed Aug. 19, 1991, by MAAKESTAD & ASSOCIATES, INC.



MAAKESTAD  
& ASSOCIATES, INC.

SURVEYING \* MAPPING \* PLANNING  
\* WATER RIGHTS \*

303 N.E. "E" STREET, GRANTS PASS, OR 97526 (503)471-1113

JOB #: 91-06

DATE: 09/24/91

PREPARED HUGO KRUYTHOFF  
FOR: P.O. BOX 1241  
GRANTS PASS, OR 97526

SHEET  
1 OF 1