

RECEIVED

SEP 17 1992



WATER RESOURCES DEPT.
SALEM, OREGON

Certified Water Right Examiner
#069 WRE
Michael E. Holladay
Michael E. Holladay
Nov. 19, 1987
STATE OF OREGON

FINAL PROOF SURVEY

UNDER
APPLICATION NO. 88842 PERMIT NO. 50971
IN NAME OF
SETH AND CAROLE KUNZ
AND
FOREST AND CATHERINE SKINNER


INSPECTED Aug 27, 1991 BY Michael E. Holladay

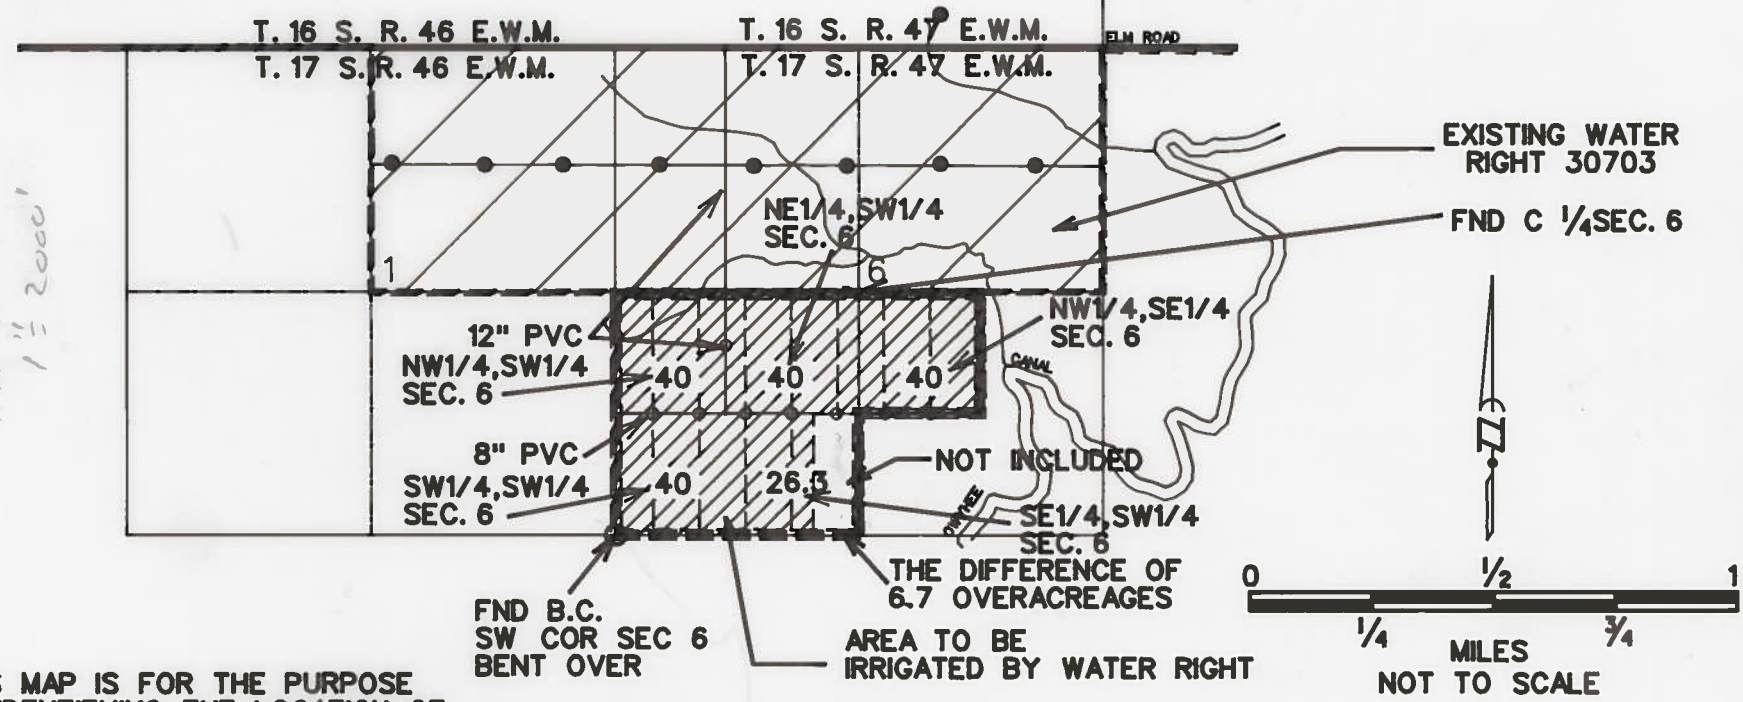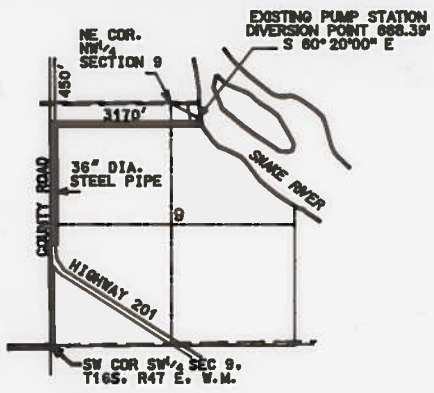

OK
ASS'S sketch
1" = 2000'

THIS MAP IS FOR THE PURPOSE
OF IDENTIFYING THE LOCATION OF
WATER RIGHTS ONLY AND IS NOT
INTENDED TO PROVIDE LEGAL DIMENSIONS
OR LOCATION OF PROPERTY LINES.

IRRIGATION BY WHEEL
LINE WITH 9/64 NOZZLES

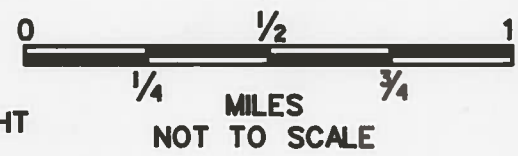

HOLLADAY ENGINEERING CO. ENGINEERS • CONSULTANTS	1431 HWY. 85, BUS. ALT. P. O. BOX 211 PAYETTE, IDAHO 83681 208-642-3304 FAX: 208-642-2150	KUNZ AND SKINNER WATER RIGHTS APPLICATION	PLOT DATE: JOB NO. 110788 DATE MAY., 1992 DN FGD ck MEH
--	--	--	--