


SEC's: 25 & 36, TWP. 2N. RANGE 14 E. W.M.  
WASCO COUNTY, OREGON

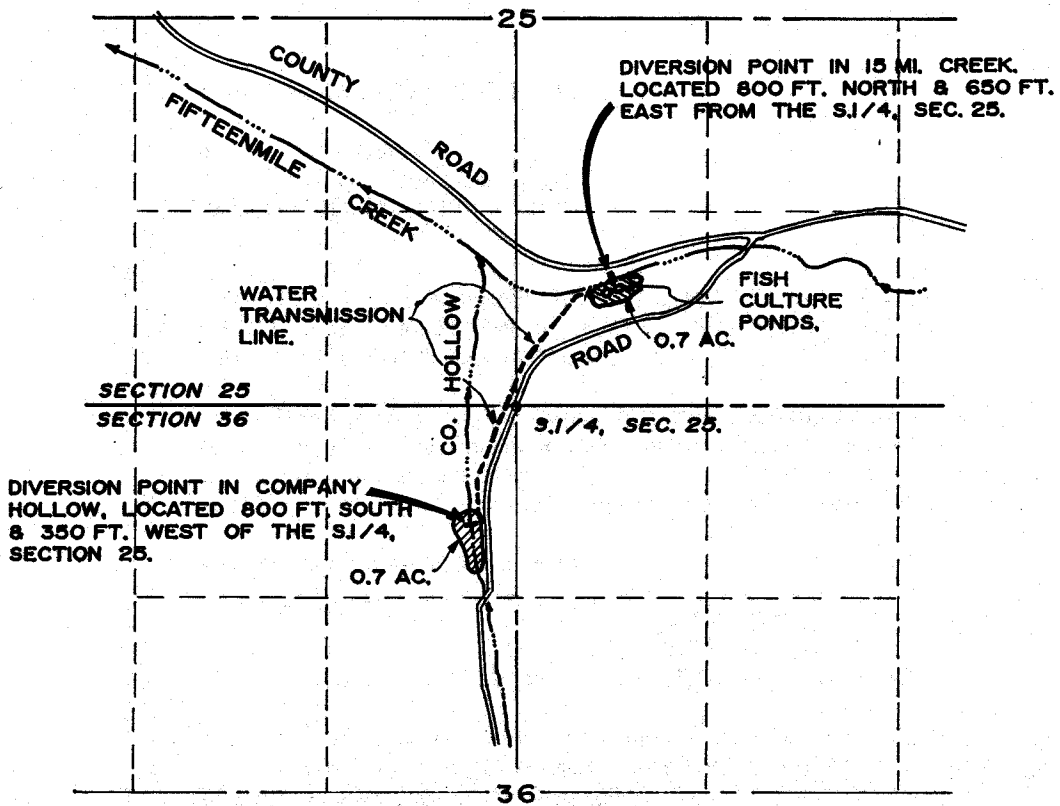

**FINAL PROOF SURVEY**

SCALE: 4" = 1 MILE

APPLICATION No. 33956

PERMIT No. 26769 & T-6207

IN THE NAME OF:

MARVIN L. MARKMAN

DATE: JULY 13, 1990

BY:

TENNESON ENGINEERING CORP.  
409 LINCOLN STREET,  
THE DALLES, OREGON, 97058  
PH. (503) 296-9177

NOTE:

"THIS MAP IDENTIFIES THE LOCATION OF THE WATER RIGHT ONLY AND IS NOT INTENDED TO PROVIDE DIMENSIONS OR LOCATE PROPERTY OWNERSHIP LINES."

