


T.23S. — R.12W., W.M.

SECTION 17

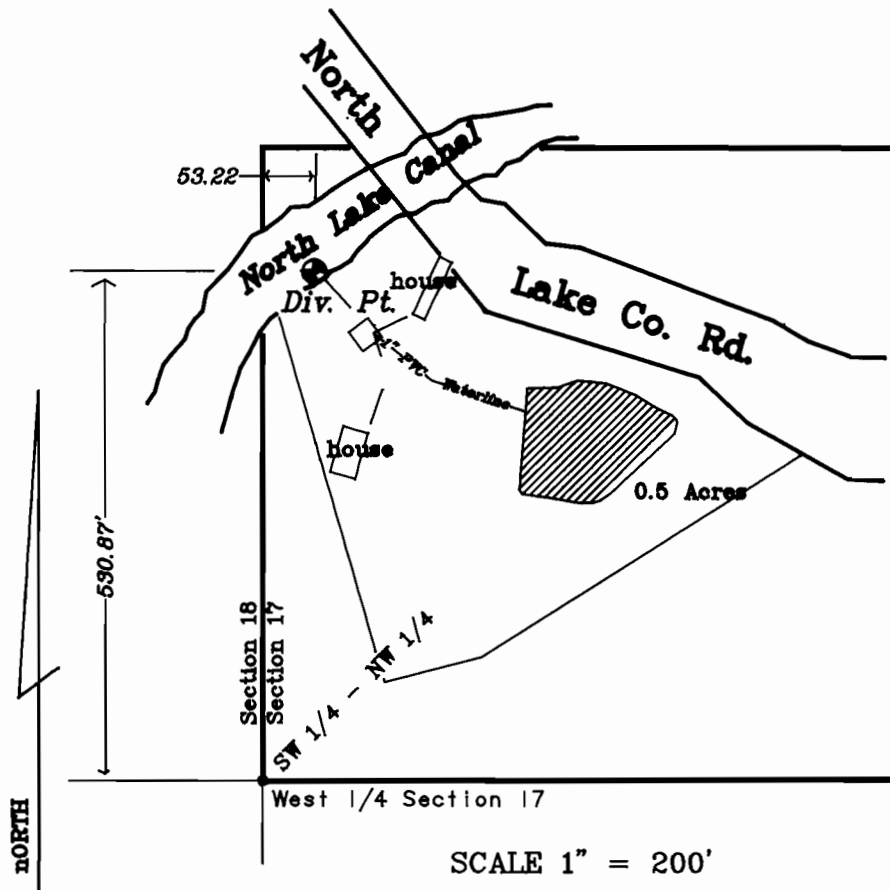

FINAL PROOF SURVEY
UNDER

Application No. 70239 Permit No. 51143

IN NAME OF
ANGELIKA BURLES

Surveyed January 06, 1992, by Russ S. Dodge

