


T.28.S., R.14W., WM

SEC. 3

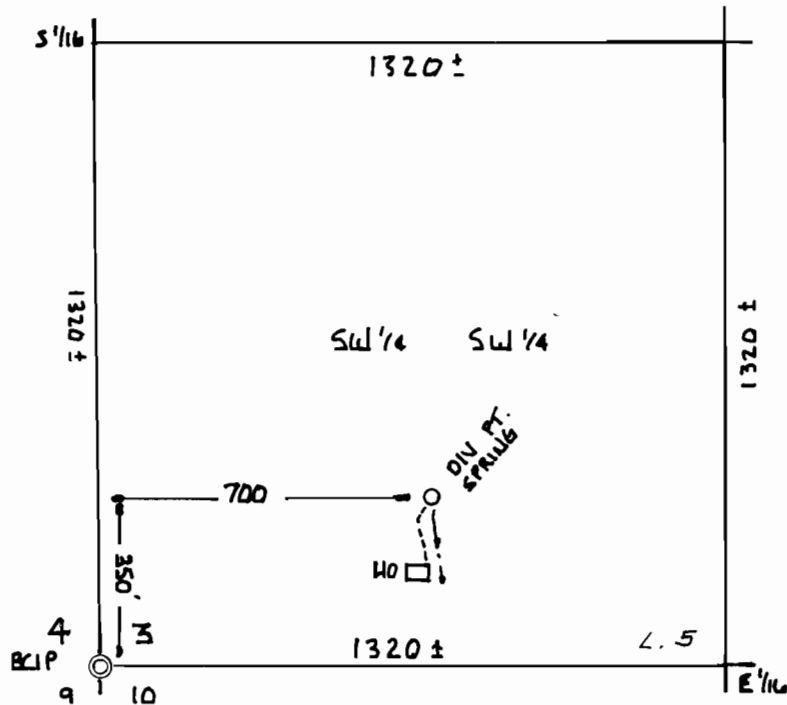

FINAL PROOF SURVEY

UNDER

APPLICATION NO: 71155 PERMIT NO. 51209

IN NAME OF

THOMAS B. & SHIRLEY A. HART

SURVEYED: JAN 1, 1992 BY: JOHN P. PRAHAR CWRE # 107.

DISCLAIMER: This map is prepared for the sole purpose of locating a water right and is in no way intended to show property line ownerships.


John P. Prahar CWRE# 107

