


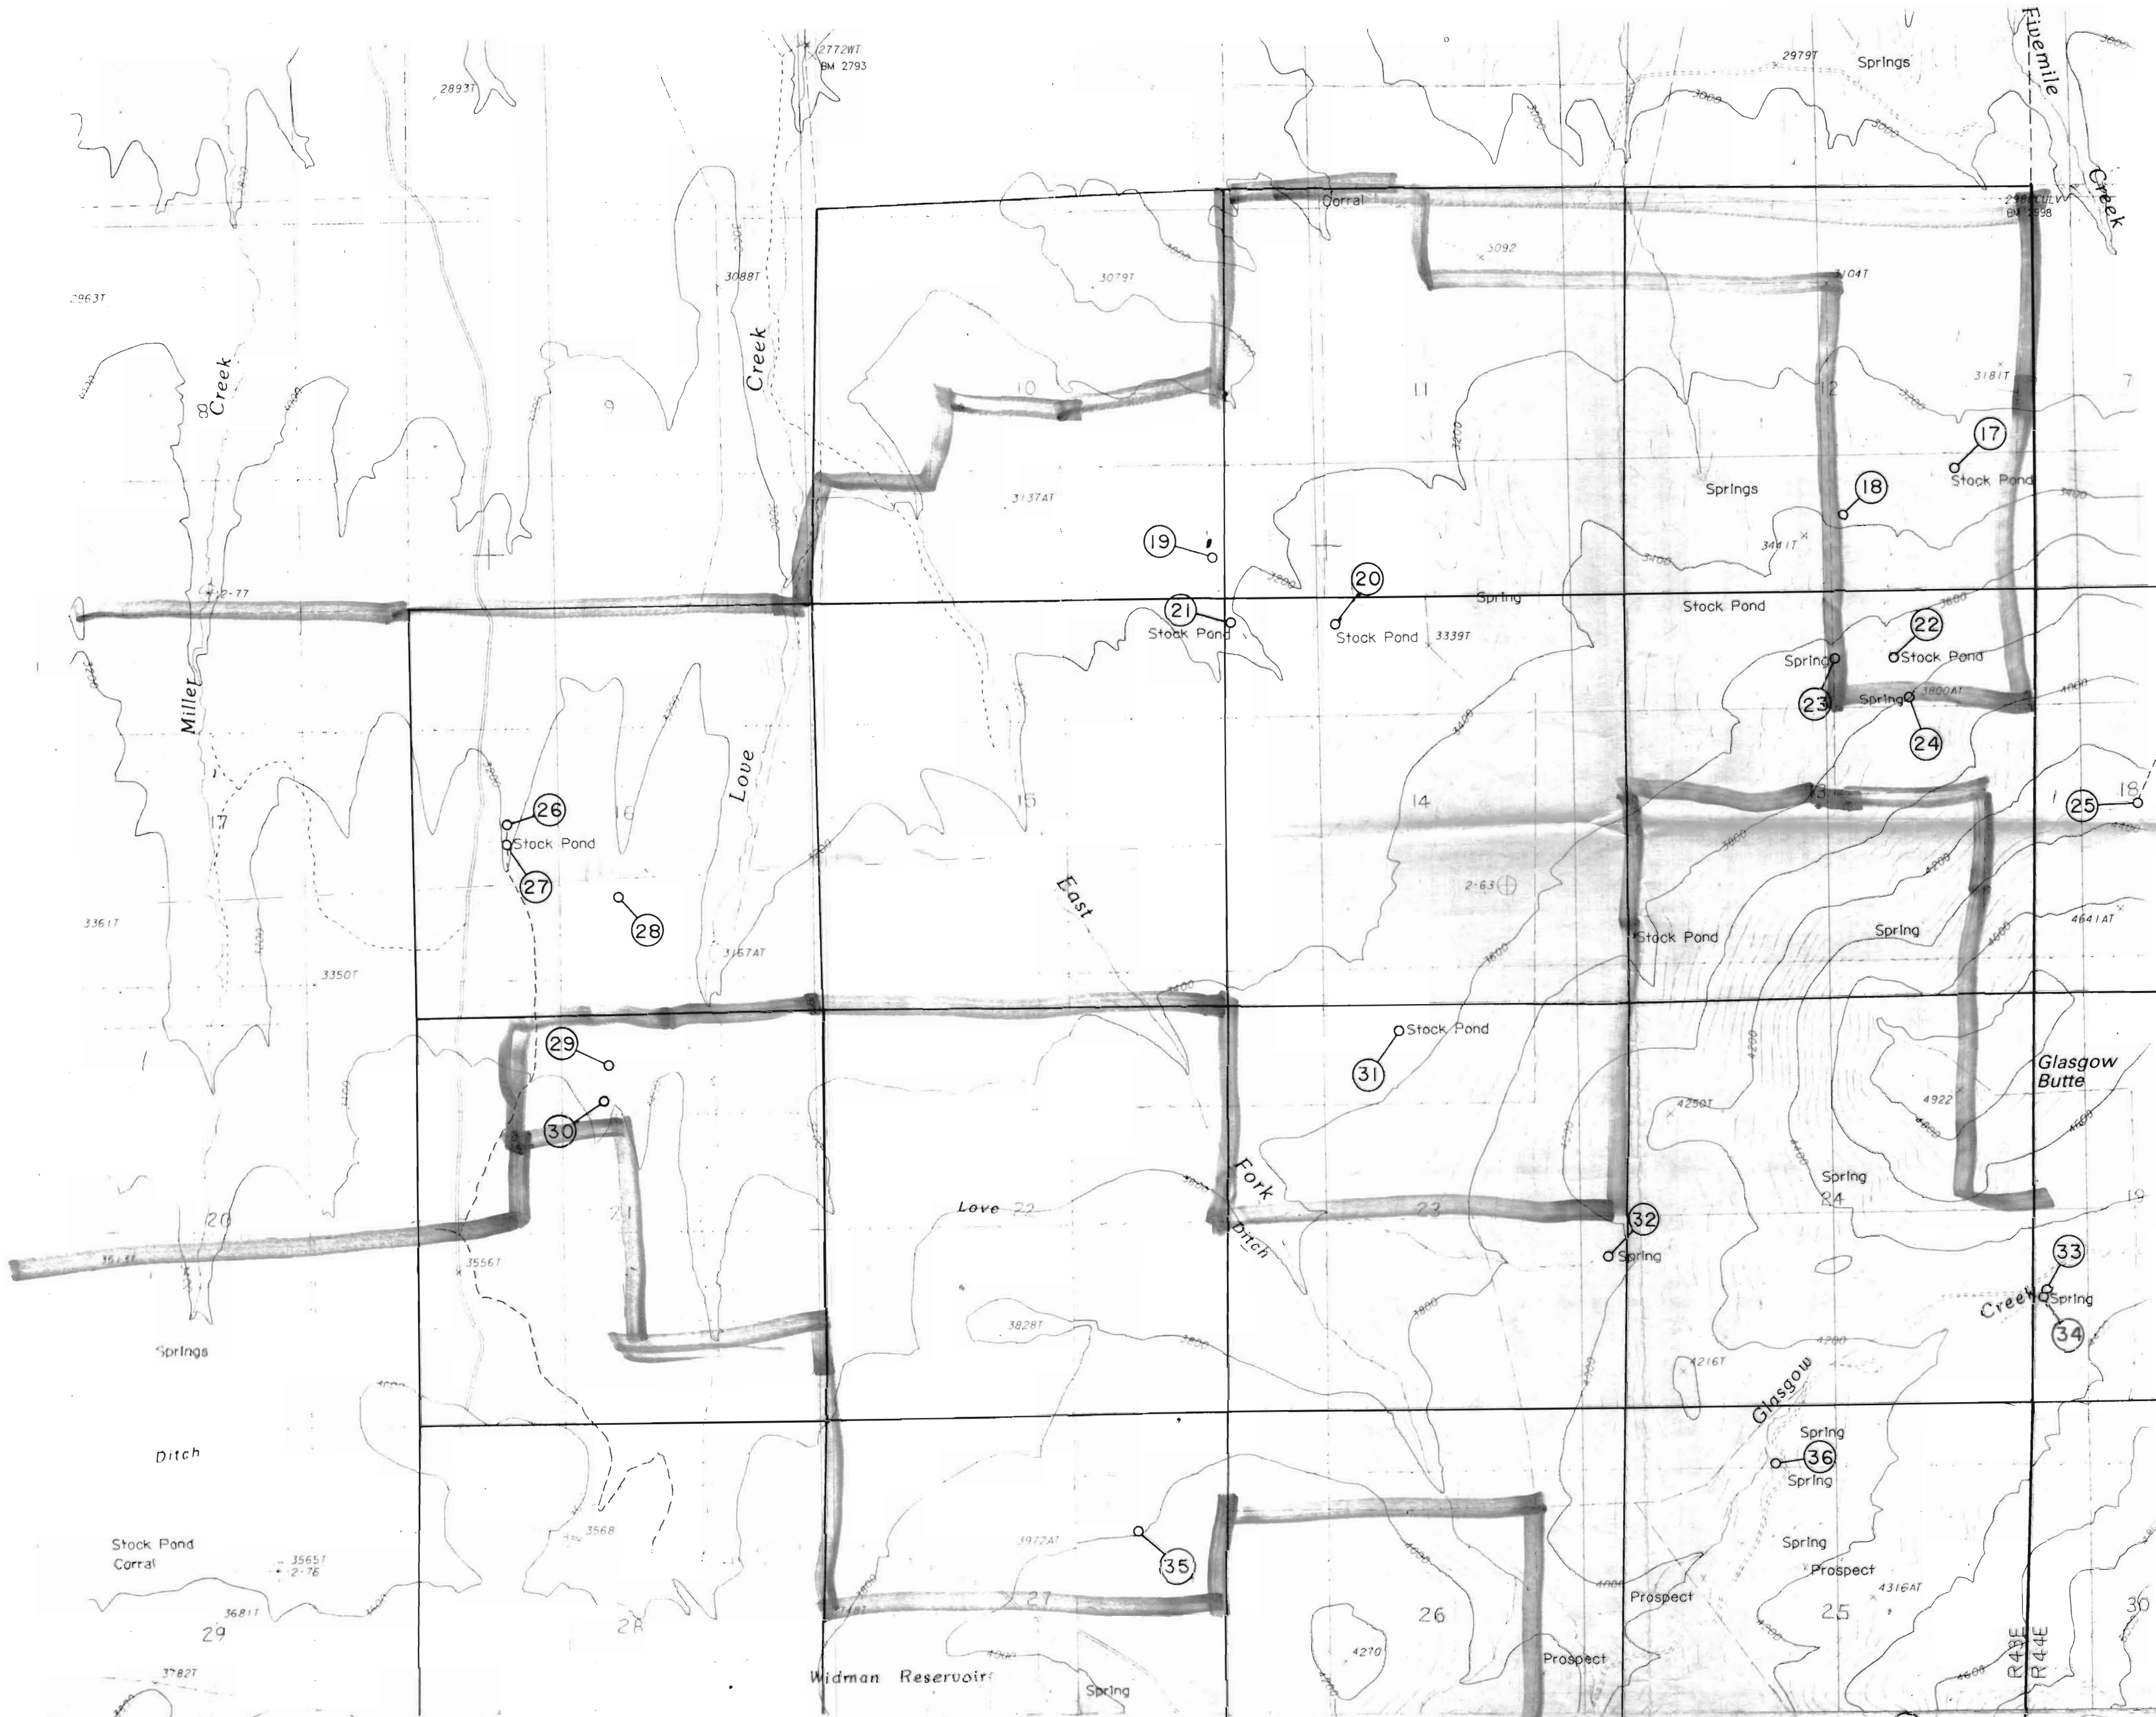

Application No. 71210-71215
Permit No.


MAP TO ACCOMPANY APPLICATION FOR PERMIT TO APPROPRIATE WATER
PHILLIPS RANCH, INC. APPLICANT

LEGEND:

17	RESERVOIR	1500 FT N	1000 FT W	SE COR SEC 12, T 9 S., R 43 E., WM
18	SPRING	1000 FT N	2550 FT W	SE COR SEC 12 " "
19	RESERVOIR	550 FT N	150 FT W	SE COR SEC 10 " "
20	RESERVOIR	350 FT S	1450 FT E	NW COR SEC 14 " "
21	RESERVOIR	300 FT S	100 FT E	NW COR SEC 14 " "
22	RESERVOIR	900 FT S	1900 FT W	NE COR SEC 13 " "
23	SPRING	900 FT S	2600 FT W	NE COR SEC 13 " "
24	RESERVOIR	1400 FT S	1700 FT W	NE COR SEC 13 " "
25	SPRING	2500 FT N	1400 FT E	SW COR SEC 18 T 9 S., R 44 E., WM
26	RESERVOIR	2500 FT N	1250 FT E	SW COR SEC 16 T 9 S., R 43 E., WM
27	RESERVOIR	2300 FT N	1200 FT E	SW COR SEC 16 " "
28	RESERVOIR	1550 FT N	2700 FT E	SW COR SEC 16 " "
29	RESERVOIR	700 FT S	2500 FT E	NW COR SEC 21 " "
30	RESERVOIR	1100 FT S	2500 FT E	NW COR SEC 21 " "
31	SPRING	300 FT S	2300 FT E	NW COR SEC 23 " "
32	SPRING	2000 FT N	200 FT W	SE COR SEC 23 " "
33	RESERVOIR	1500 FT N	200 FT E	SW COR SEC 19 T 9 S., R 44 E., WM
34	TROUGH	1350 FT N	100 FT E	SW COR SEC 19 " "
35	SPRING	1500 FT S	1200 FT W	NE COR SEC 27 T 9 S., R 43 E., WM
36	SPRING	750 FT S	2000 FT E	NW COR SEC 25 " "
37	SPRING	700 FT N	2000 FT W	SE COR SEC 25 " "
38	SPRING	300 FT S	800 FT W	NE COR SEC 35 " "
39	SPRING	1100 FT S	600 FT W	NE COR SEC 35 " "
40	SPRING	2600 FT S	500 FT W	NE COR SEC 35 " "
41	SPRING	1700 FT N	1000 FT W	SE COR SEC 35 " "
42	SPRING	1300 FT N	2200 FT E	SW COR SEC 36 " "
43	SPRING	600 FT S	1950 FT W	NE COR SEC 1 T 10 S., R 43 E., WM
44	SPRING	2400 FT N	2300 FT W	SE COR SEC 36 T 9 S., R 43 E., WM
45	SPRING	800 FT S	200 FT E	NW COR SEC 31 T 9 S., R 44 E., WM
46	SPRING	1100 FT S	500 FT E	NW COR SEC 31 " "
47	SPRING	2400 FT N	700 FT W	SE COR SEC 36 T 9 S., R 43 E., WM
48	SPRING	2000 FT N	400 FT W	SE COR SEC 36 " "
49	SPRING	400 FT N	600 FT W	SE COR SEC 36 " "
50	SPRING	50 FT N	100 FT W	SE COR SEC 36 " "
51	SPRING	550 FT N	1700 FT W	SE COR SEC 31 T 9 S., R 44 E., WM
52	SPRING	600 FT N	1500 FT W	SE COR SEC 31 " "
53	SPRING	2000 FT N	600 FT W	SE COR SEC 31 " "
54	SPRING	2600 FT S	200 FT W	NE COR SEC 31 " "
55	SPRING	2300 FT S	100 FT W	NE COR SEC 31 " "
56	SPRING	2300 FT S	100 FT E	NW COR SEC 32 " "
57	SPRING	2100 FT S	1600 FT E	NW COR SEC 32 " "
58	SPRING	1200 FT N	200 FT E	SW COR SEC 32 " "
59	SPRING	900 FT N	1000 FT W	SE COR SEC 32 " "
60	RESERVOIR	2300 FT S	800 FT W	NE COR SEC 5 T 10 S., R 44 E., WM
61	RESERVOIR	400 FT N	200 FT W	SE COR SEC 5 " "
62	SPRING	1000 FT E	2550 FT E	NW COR SEC 9 " "
63	SPRING	200 FT S	2300 FT E	NW COR SEC 7 " "
64	SPRING	100 FT S	2100 FT E	NW COR SEC 12 T 10 S., R 43 E., WM
65	SPRING	2150 FT S	2400 FT W	NE COR SEC 12 " "
66	SPRING	1200 FT S	1500 FT W	NE COR SEC 12 " "
67	SPRING	1500 FT S	100 FT W	SE COR SEC 12 T 10 S., R 44 E., WM
68	SPRING	300 FT N	200 FT W	NE COR SEC 7 T 10 S., R 44 E., WM
69	SPRING	1700 FT S	800 FT W	SE COR SEC 7 " "
70	SPRING	2400 FT N	2000 FT W	NE COR SEC 18 " "
71	SPRING	1600 FT S	500 FT W	NE COR SEC 17 " "
72	SPRING	1100 FT S	1300 FT E	SW COR SEC 16 " "
73	RESERVOIR	1100 FT N	900 FT W	SE COR SEC 16 " "
74	SPRING	800 FT N	900 FT W	SE COR SEC 16 " "
75	SPRING	200 FT S	900 FT W	SE COR SEC 16 " "

SCALE 1" = 1320'

SHEET 2 OF 2

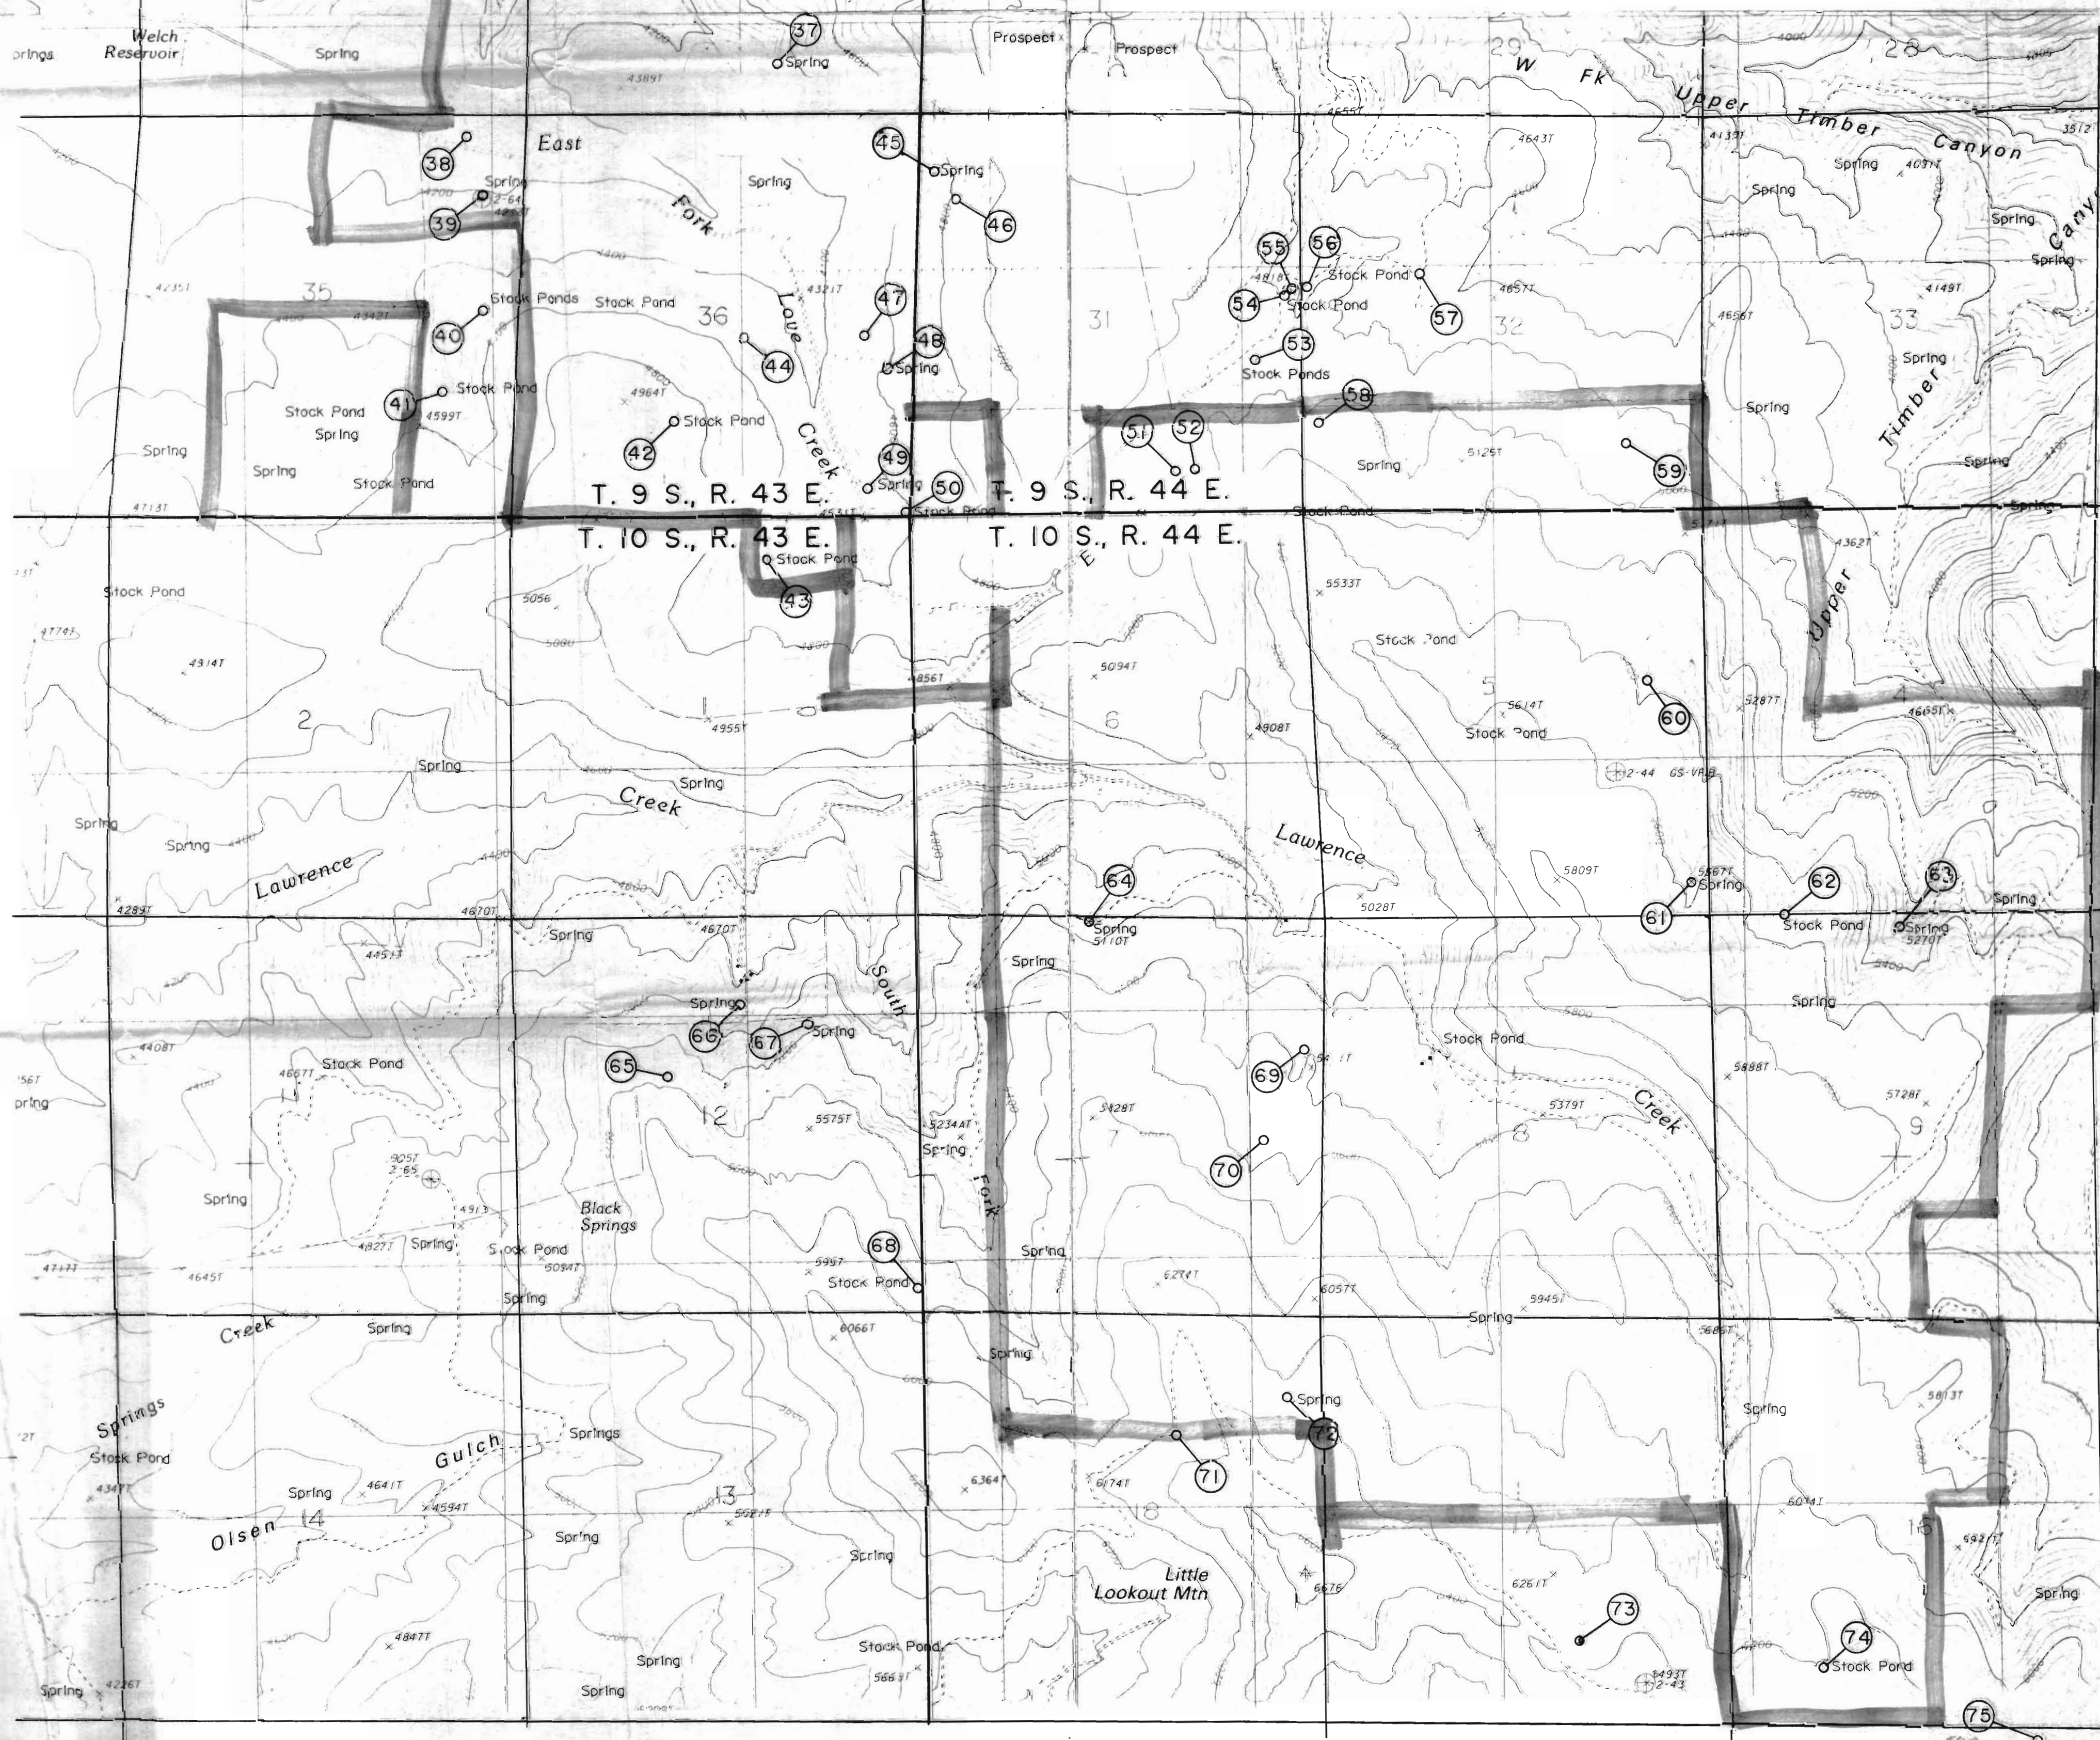

RECEIVED

JAN 28 1991

WATER RESOURCES DEPT.
SALEM, OREGON

