


T. 7 S., R. 45 E., W.M.

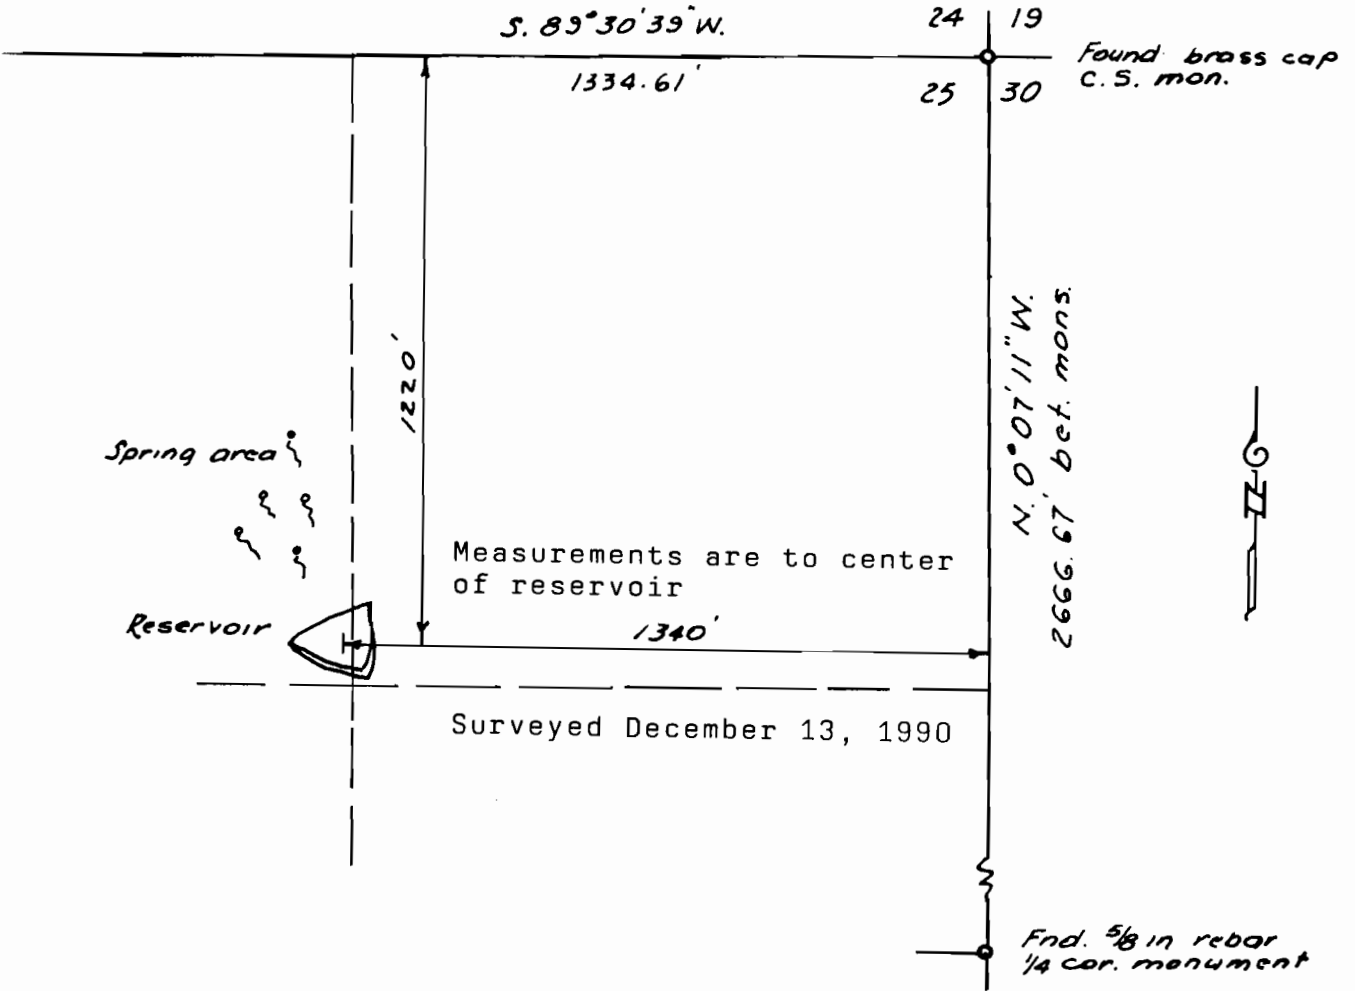

R-71385

CERT# 68785

MAP TO ACCOMPANY APPLICATION FOR PERMIT  
TO APPROPRIATE WATER

1" = 400'

Applicant Maryellen Olson

