

Application No. ~~R-71740~~
Permit No.

cert - 68786

T 6 S R 38 E WM

RECEIVED

JUL 05 1991


WATER RESOURCES DEPT.
SALEM, OREGON

RECEIVED

JUN 24 1991

WATER RESOURCES DEPT.
SALEM, OREGON

020222

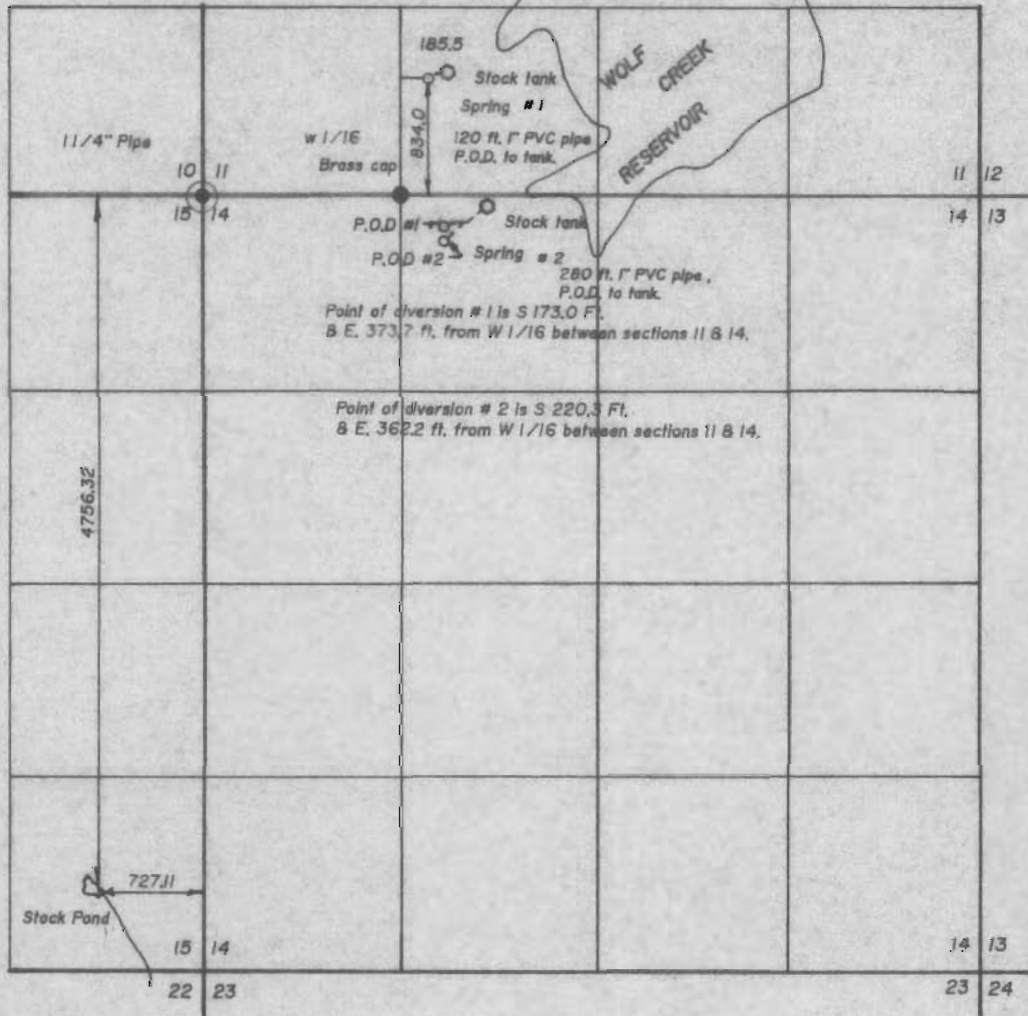

NOTE: The preparation of this map was for the purpose of identifying the location of the proposed water right and has no intent to provide dimensions or location of property ownership lines.

APPLICATION MAP FOR WATER RIGHTS

FOR
NORMAN RECORDS

BY
BAGETT-GRIFFITH & ASSOCIATES
2006 ADAMS AVENUE
LAGRANDE, OREGON 97850

JUNE 6, 1991

