

5

RECEIVED

APR 30 1992

WATER RESOURCES DEPT.
SALEM, OREGON

Appl. No. R-72375
72374



T 6 & 7 S R 40 E WM

68803



SCALE: 1" = 1320'

APPLICATION MAP FOR WATER RIGHTS

For
THE HART ESTATE INVESTMENT
COMPANY

DATE: April 15, 1992

T 6 S
T 7 S

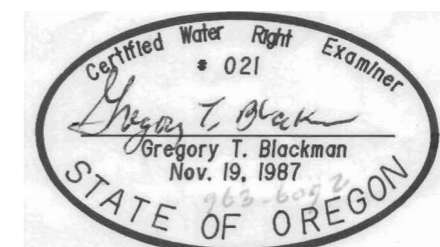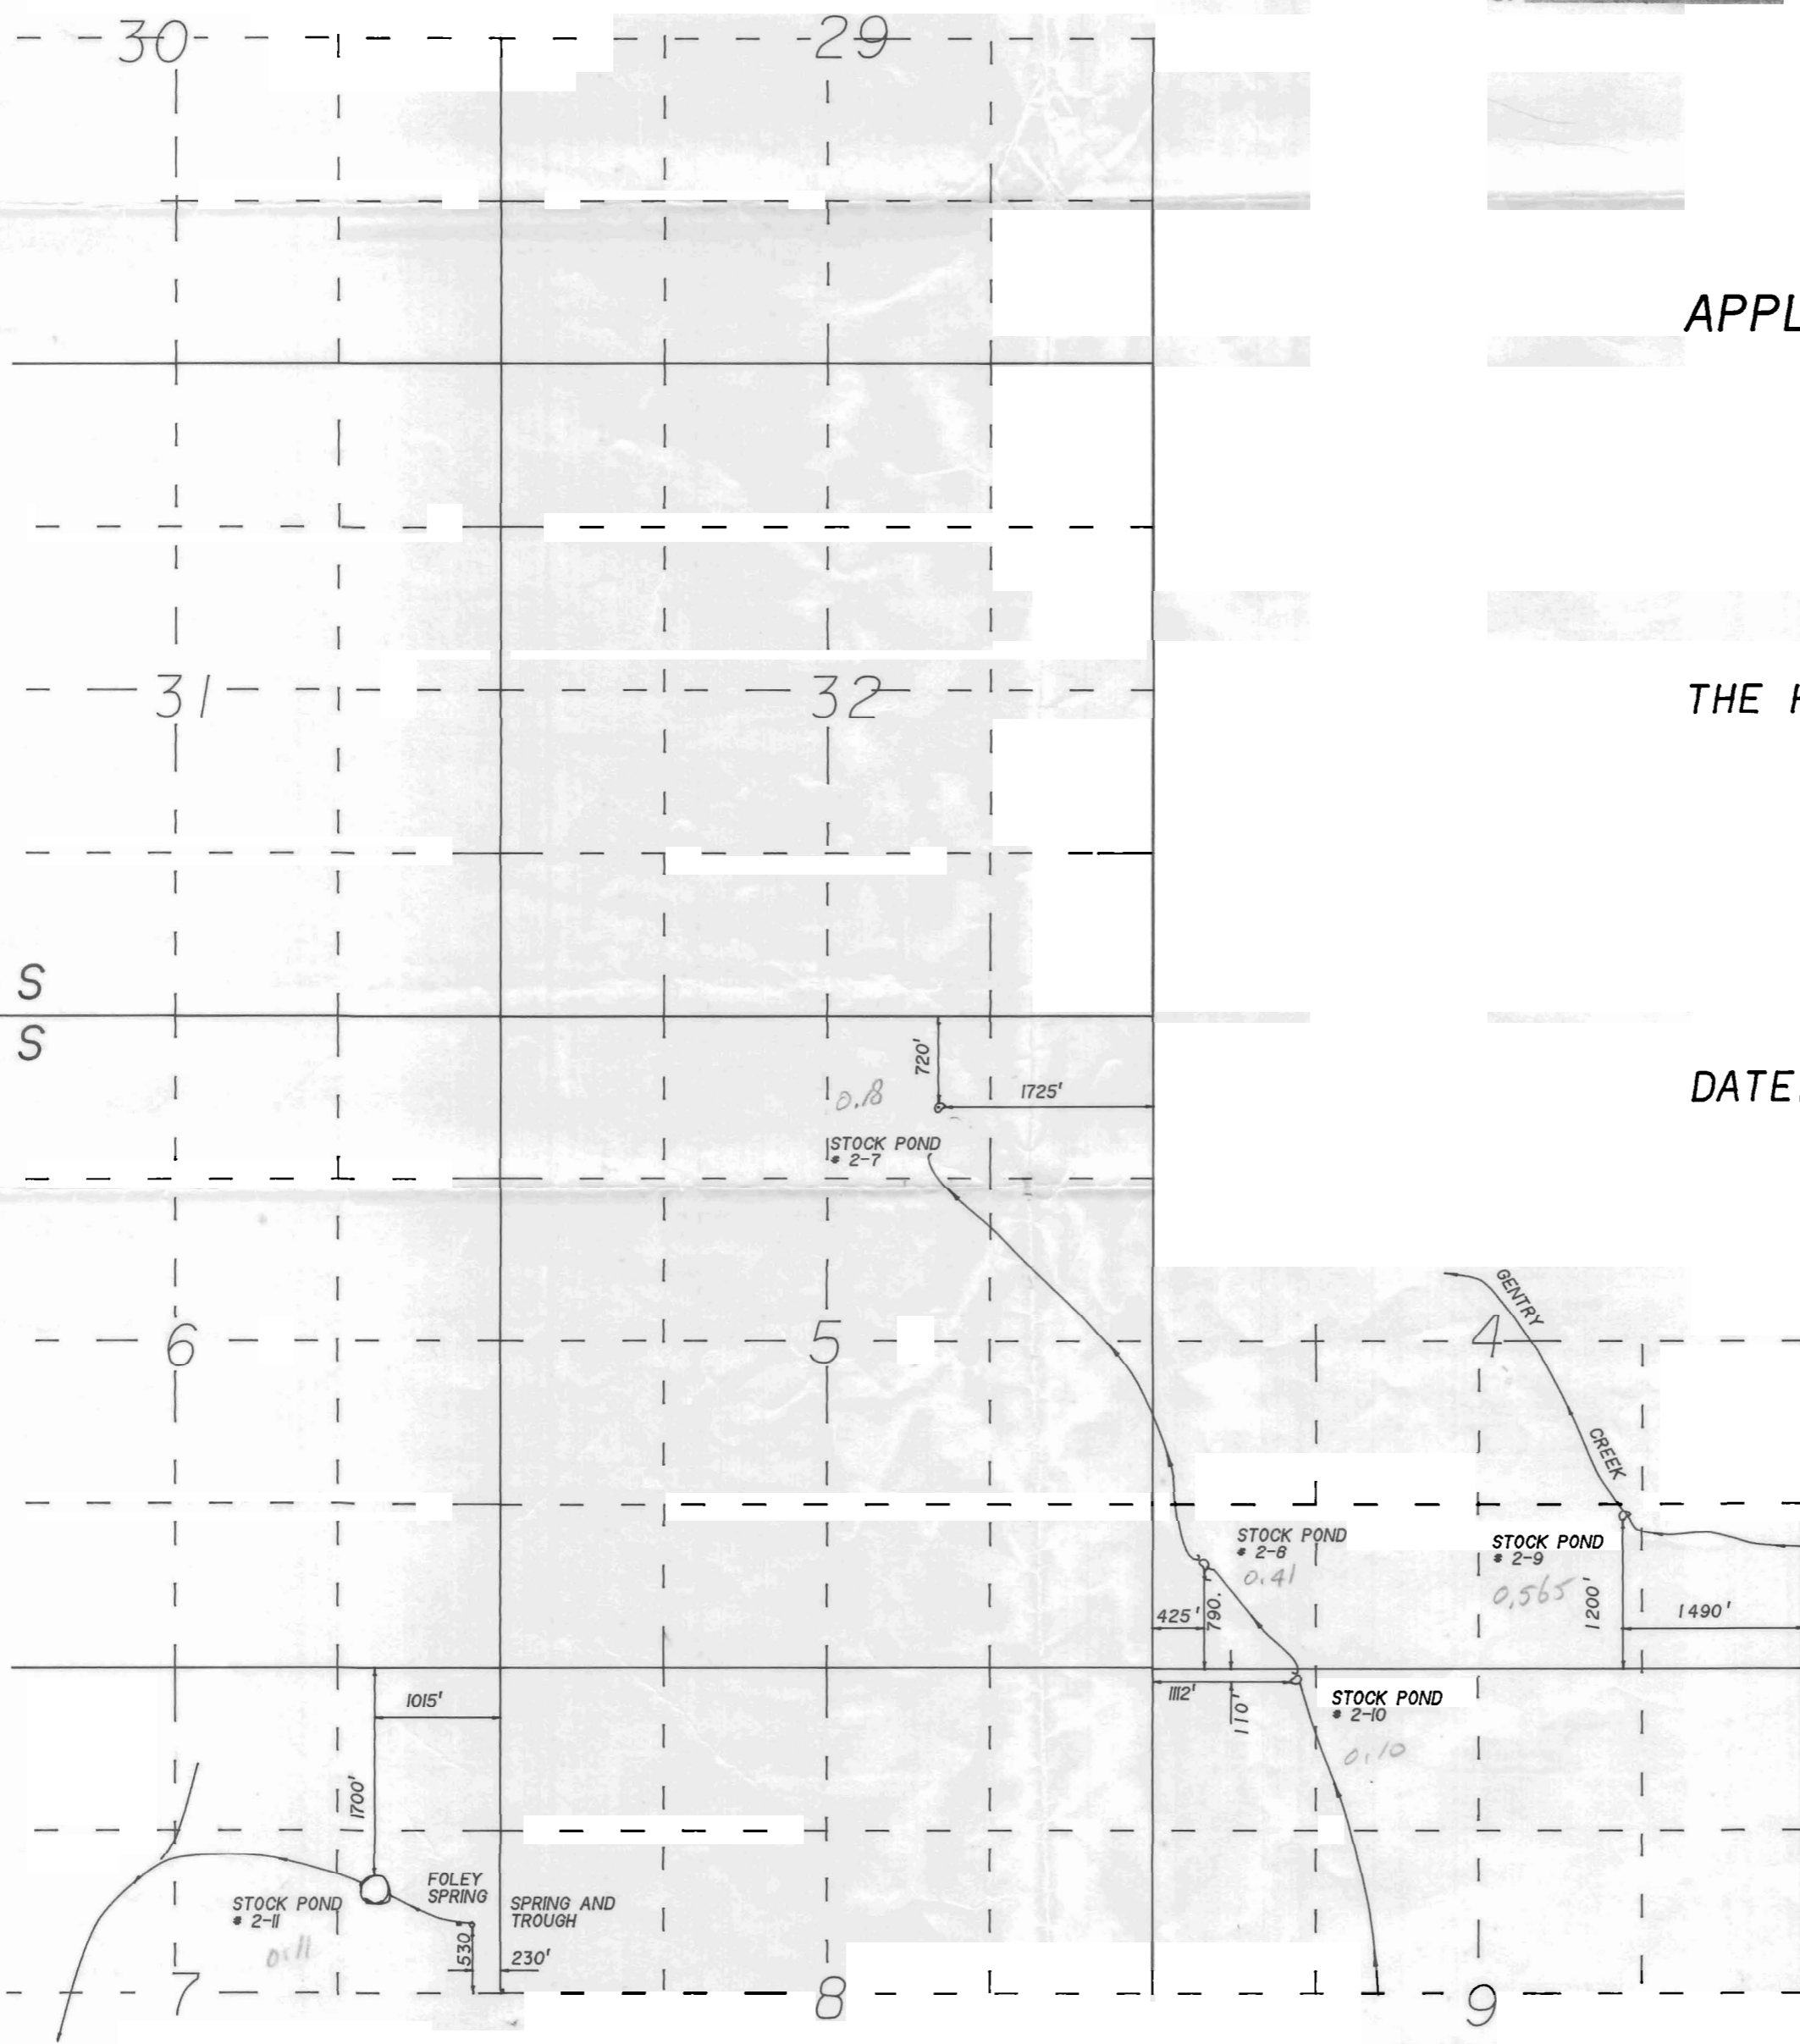

BAGETT-GRIFFITH & ASSOCIATES
 2006 Adams Avenue
 LaGrande, Oregon 97850

NOTE: The preparation of this map was for the purpose of identifying the location of the proposed water right and has no intent to provide dimensions or location of property ownership lines. Location information shown hereon was furnished by the applicant.