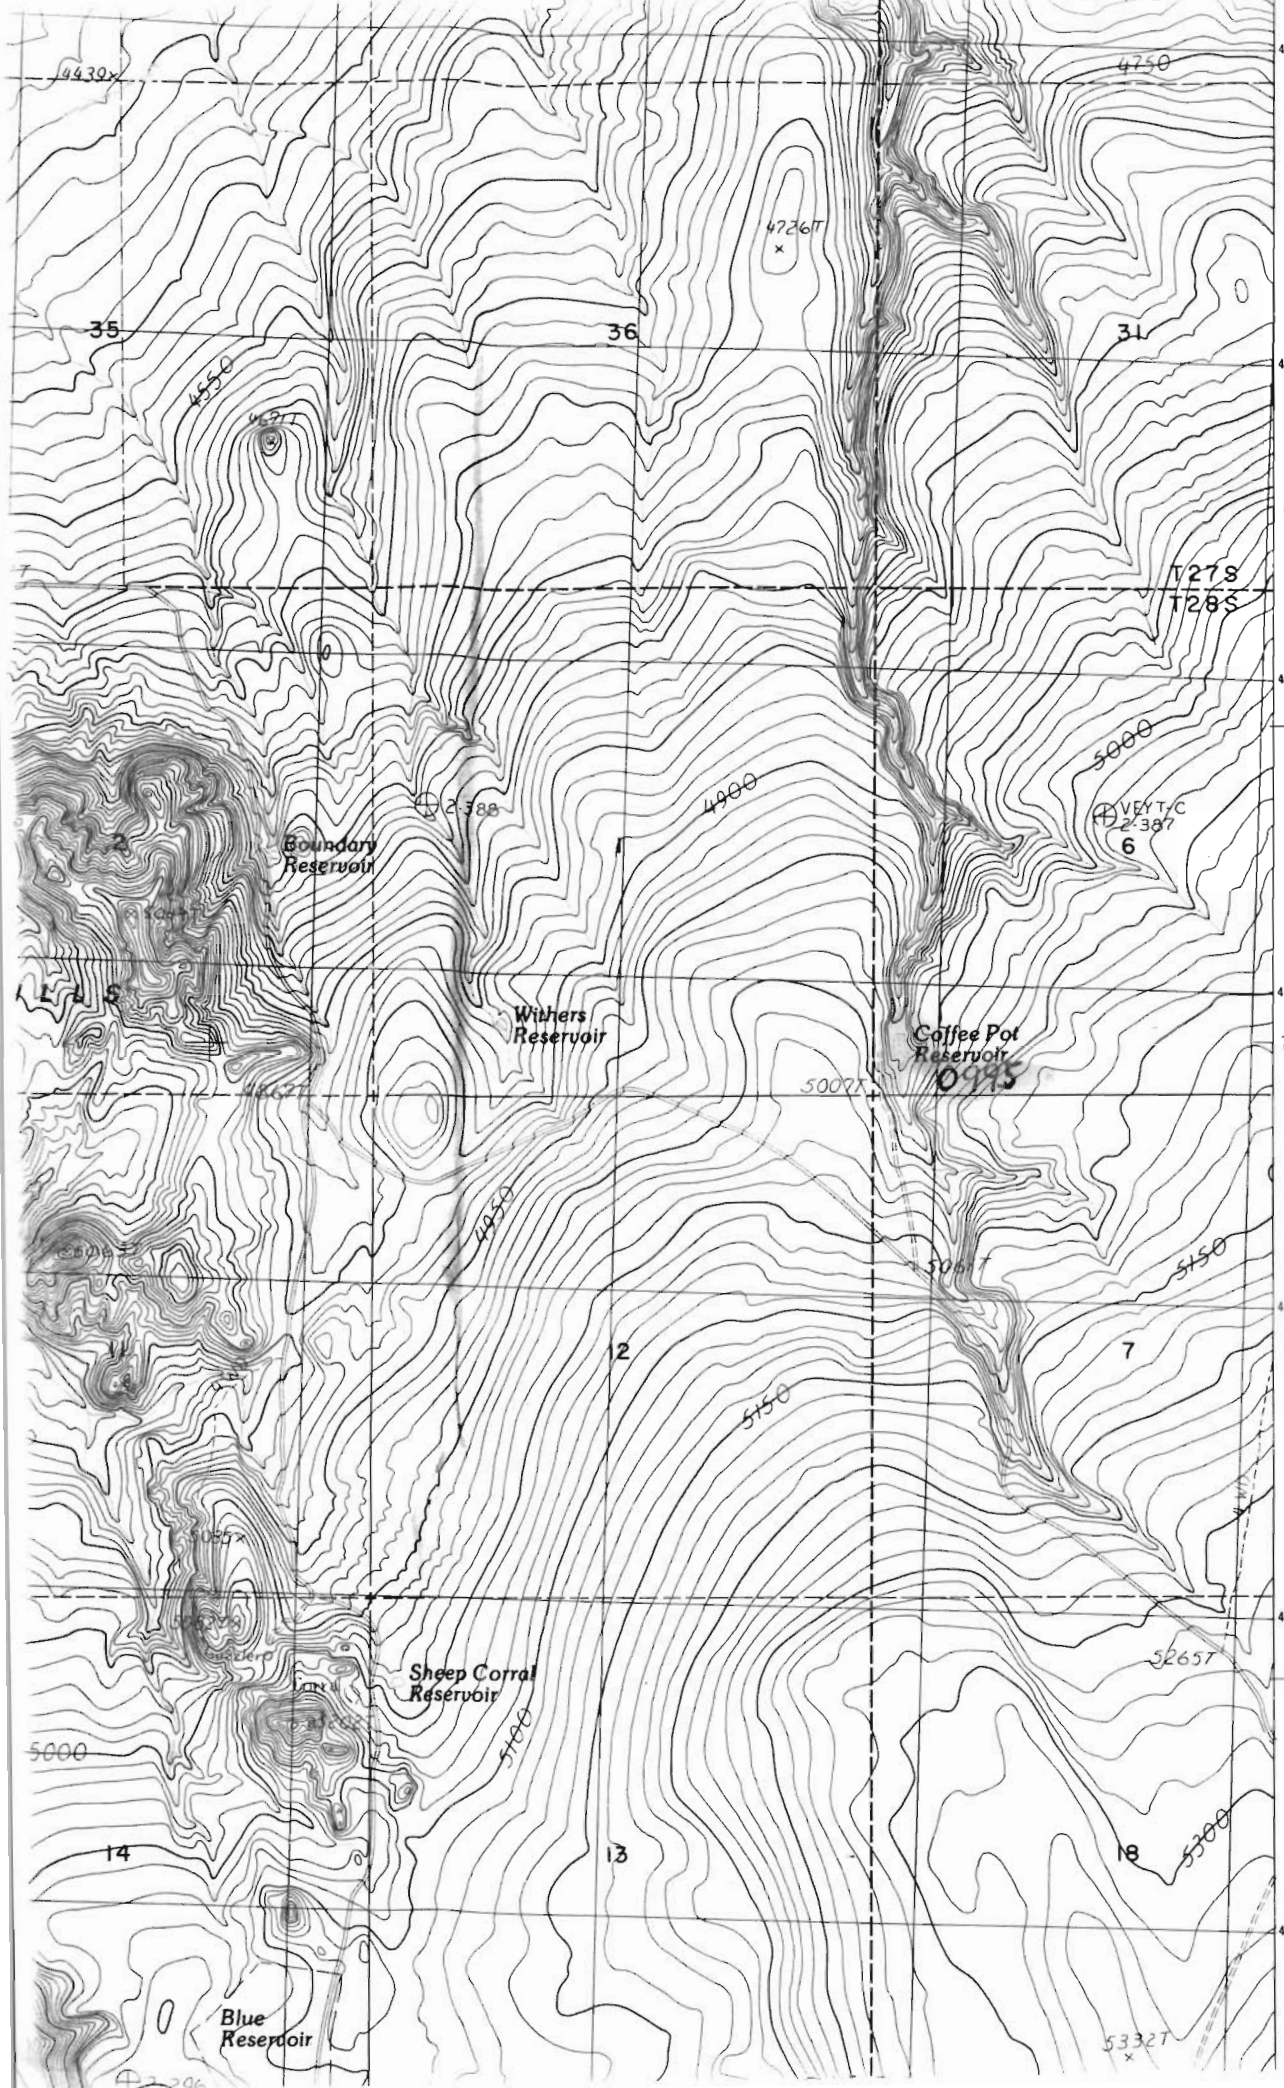

RECEIVED
SEP 23 1992
WATER RESOURCES DEPT
SALEM, OREGON

"CERTIFICATE NO. 68810"