


CERTIFICATE NO.

68812

WATER RESOURCES DEPT
SALEM, OREGON

SEP 23 1992

RECEIVED

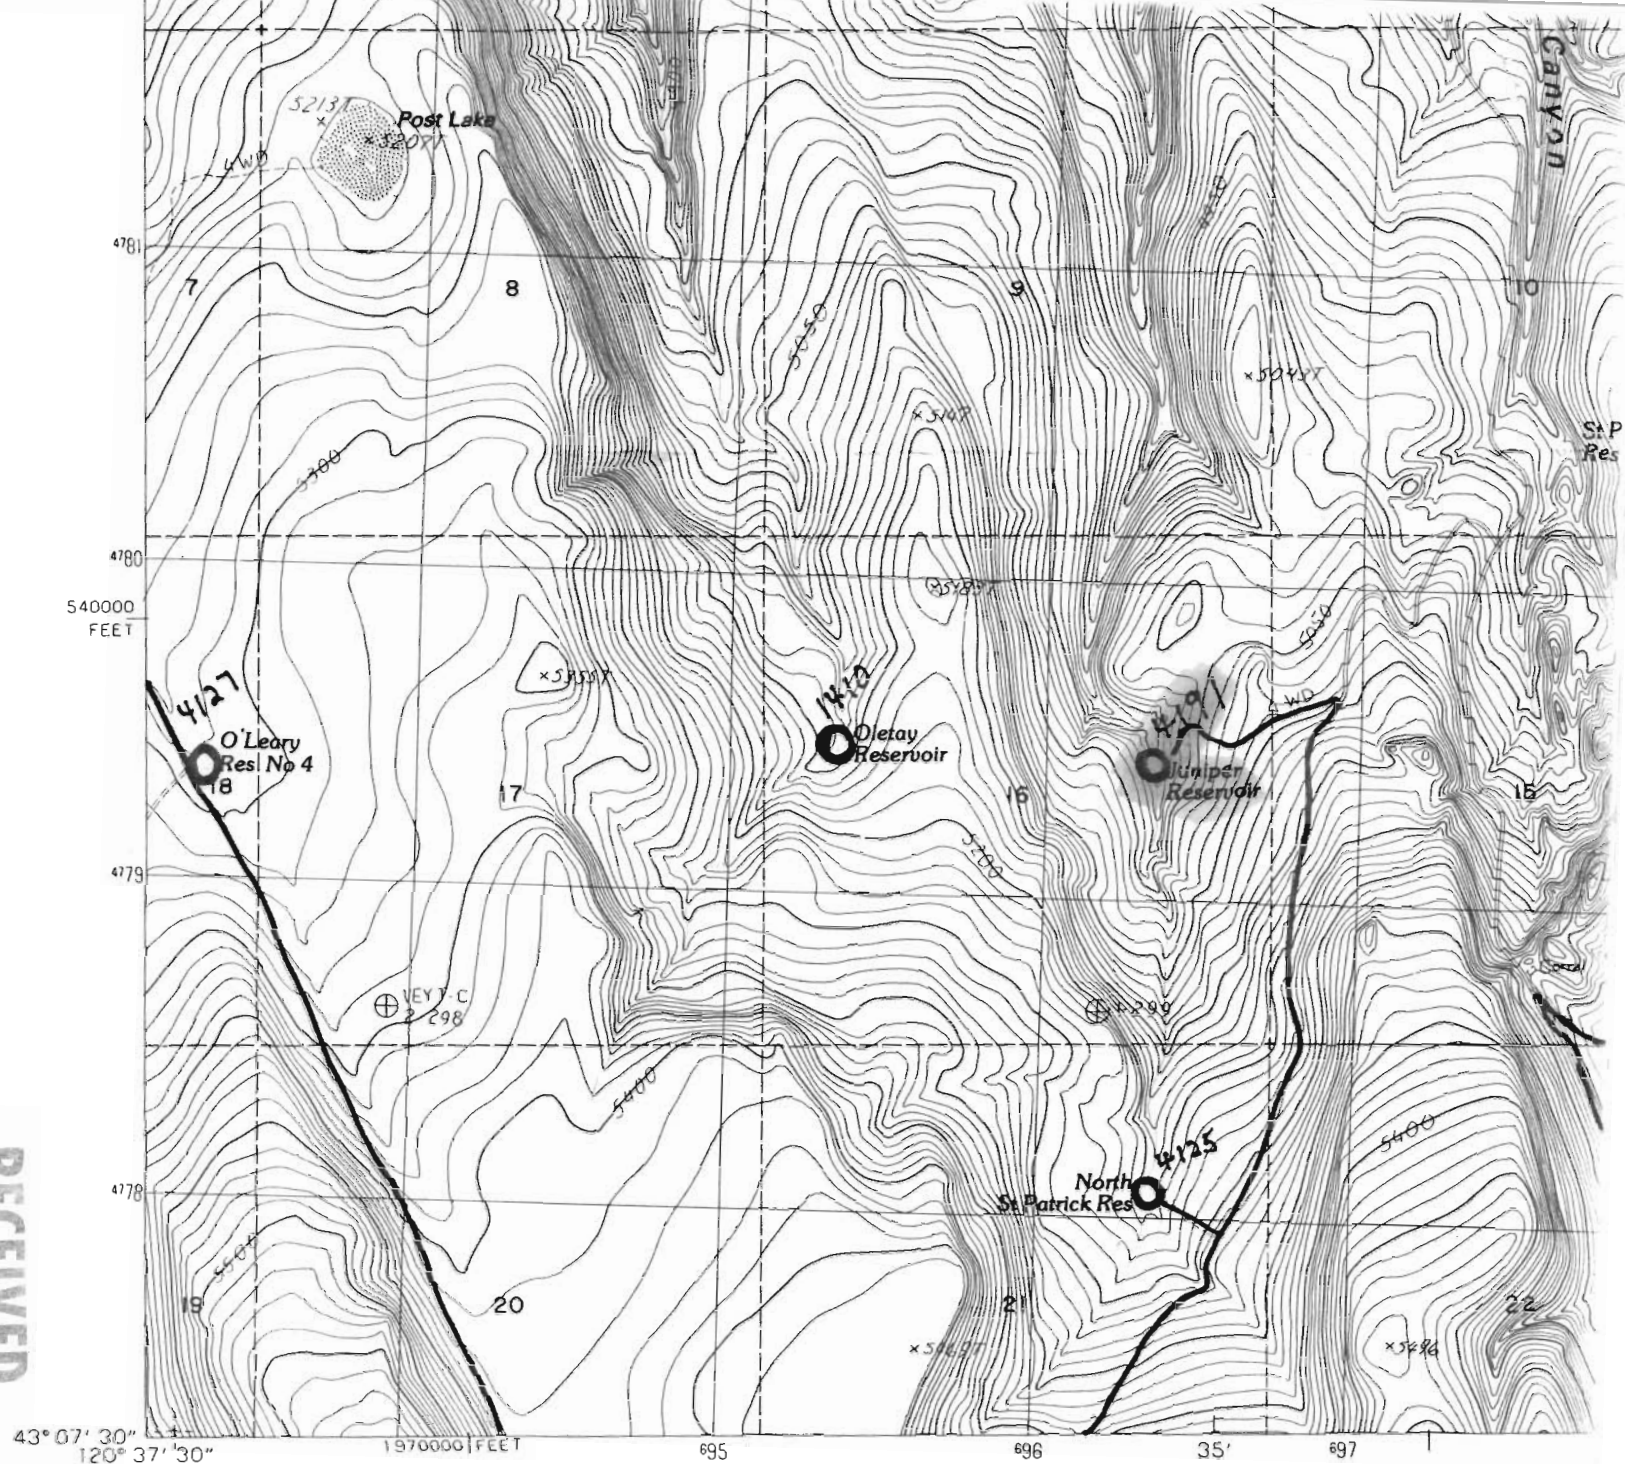

PRODUCED BY THE UNITED STATES GEOLOGICAL SURVEY
CONTROL BY USGS, NOS/NOAA
COMPILED FROM AERIAL PHOTOGRAPHS TAKEN 1980
FIELD CHECKED 1981. MAP EDITED 1986
PROJECTION LAMBERT CONFORMAL CONIC