


CERTIFICATE NO. 68844

T. 38 S., R. 5 E., W.M.

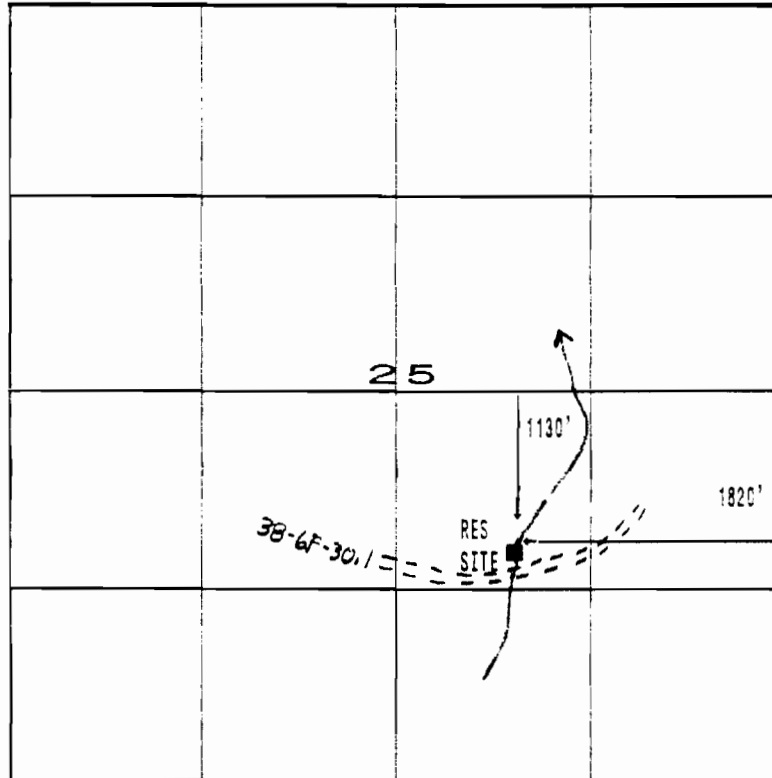

SEP 27 1992

WATER RIGHT EXAMINER
STATE OF OREGON

N



1" = 1320'

APPLICATION MAP


FOR

BIG FIRS PUMP CHANCE

IN NAME OF

UNITED STATES BUREAU OF LAND MANAGEMENT

JULY 24, 1991

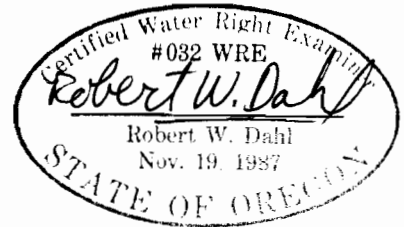

THE PURPOSE OF THIS MAP IS FOR IDENTIFYING THE LOCATION OF THE WATER RIGHT ONLY AND IS NOT INTENDED TO PROVIDE LEGAL DIMENSIONS OR LOCATION OF PROPERTY OWNERSHIP LINES.

BLM PROJECT NO. W

WRE 6038A OREGON

U.S. BUREAU OF LAND MANAGEMENT - OSO
BRANCH OF CADASTRAL SURVEY
LETTER OF AUTHORIZATION
DATED: MAY 31, 1991

EXECUTED BY:
ROBERT W. DAHL, RLS, CWRE
P.O. BOX 1374
WALDPOR, OREGON 97394