


Application No: R-72745
Permit No:

FINAL PROOF MAP

"CERTIFICATE NO. 68815"

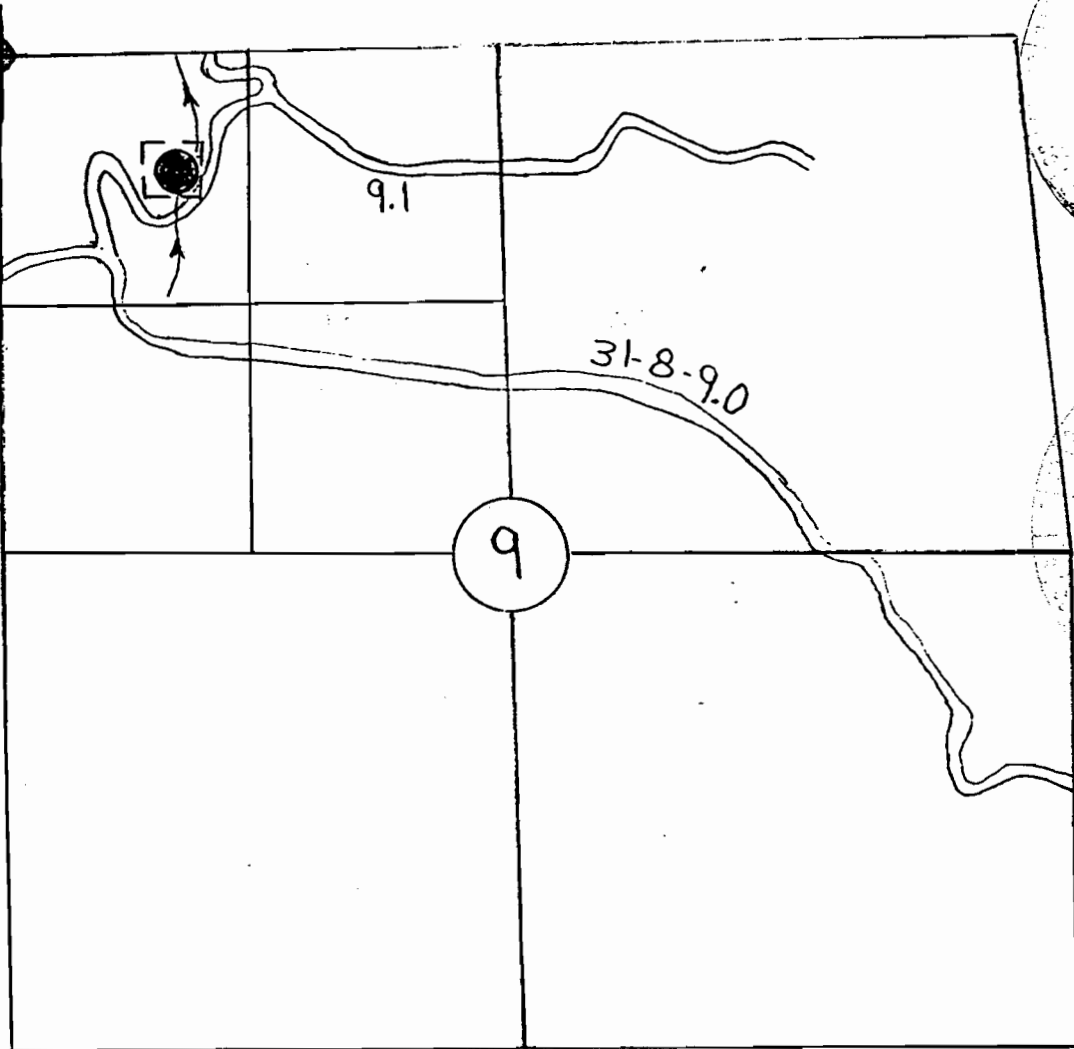


MICHIGAN SPRINGS HELIPOND
T31S R8W Sec 9
NW $\frac{1}{4}$ NW $\frac{1}{4}$

The point of diversion is located 550 ft South and 1050 ft East from the Northwest Section corner of Section 9.

Coordinate Ties are based on aerial photo 3-17-13-89.

The map is shown for the purpose of water application and not property boundary.

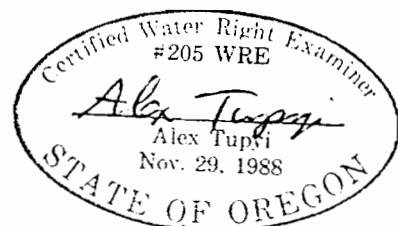

3-5-90