


Application No. 72748 + R 72747


Permit No.

FINAL PROOF MAP

"CERTIFICATE NO. 68846"

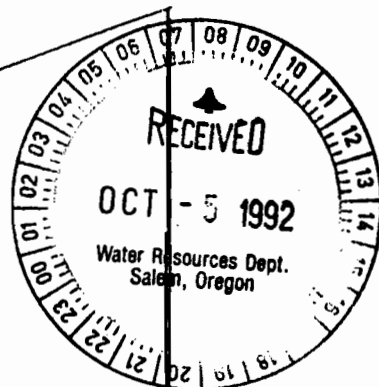

Scale 1" = 1000'

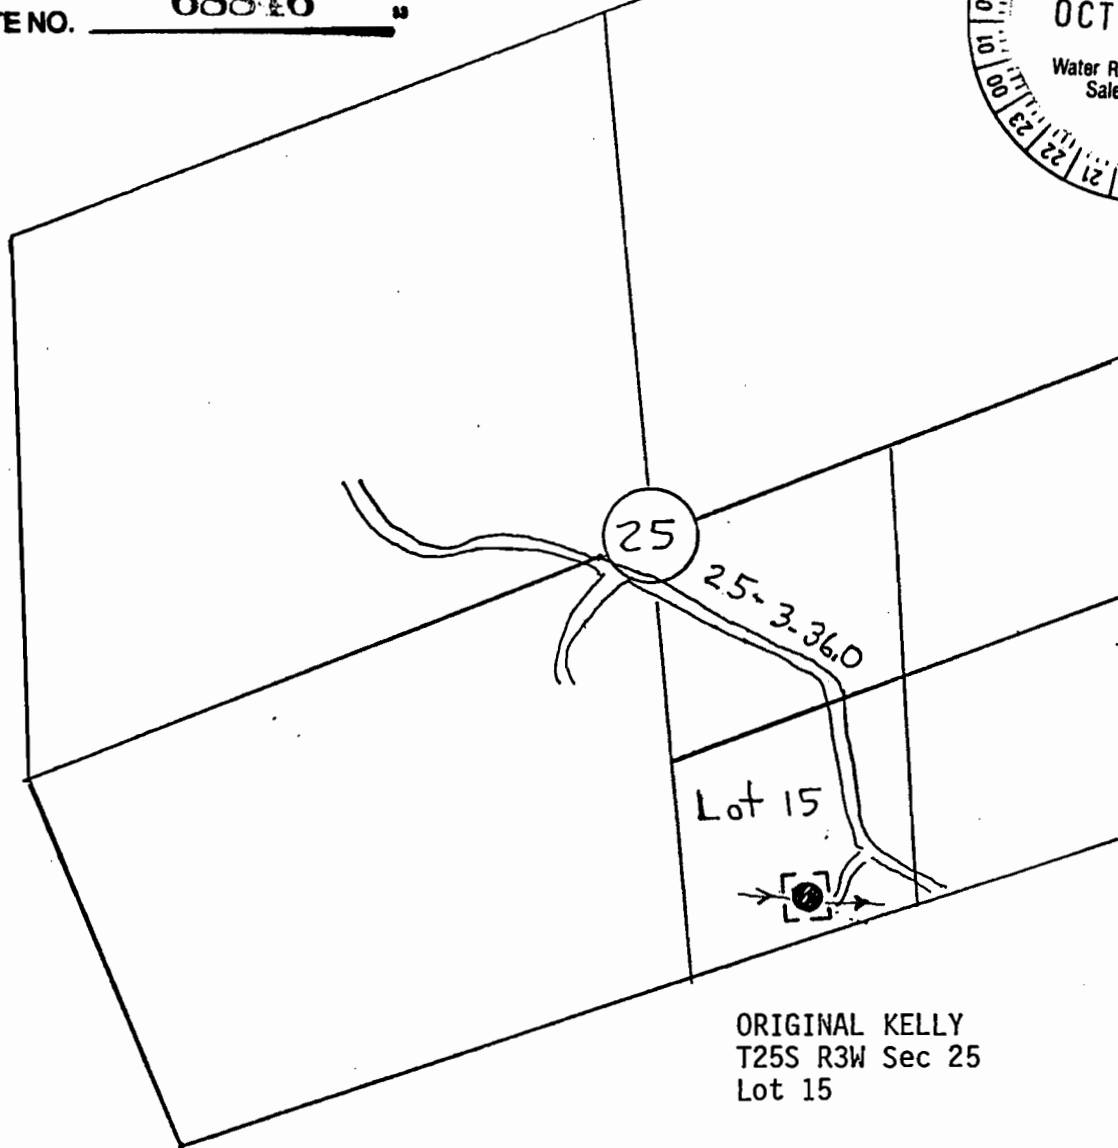


ORIGINAL KELLY
T25S R3W Sec 25
Lot 15

The point of diversion is located 400 ft South and 1600 ft West from the Southeast Section corner of Section 25.

Coordinate Ties are based on aerial photo 7-40-56.

The map is shown for the purpose of water application and not property boundary.

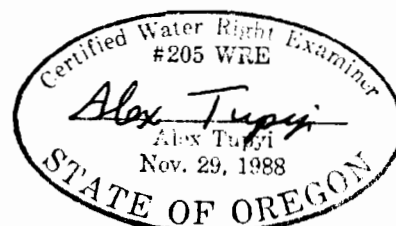

4-22-91