


Permit No.

"CERTIFICATE NO. 68852"

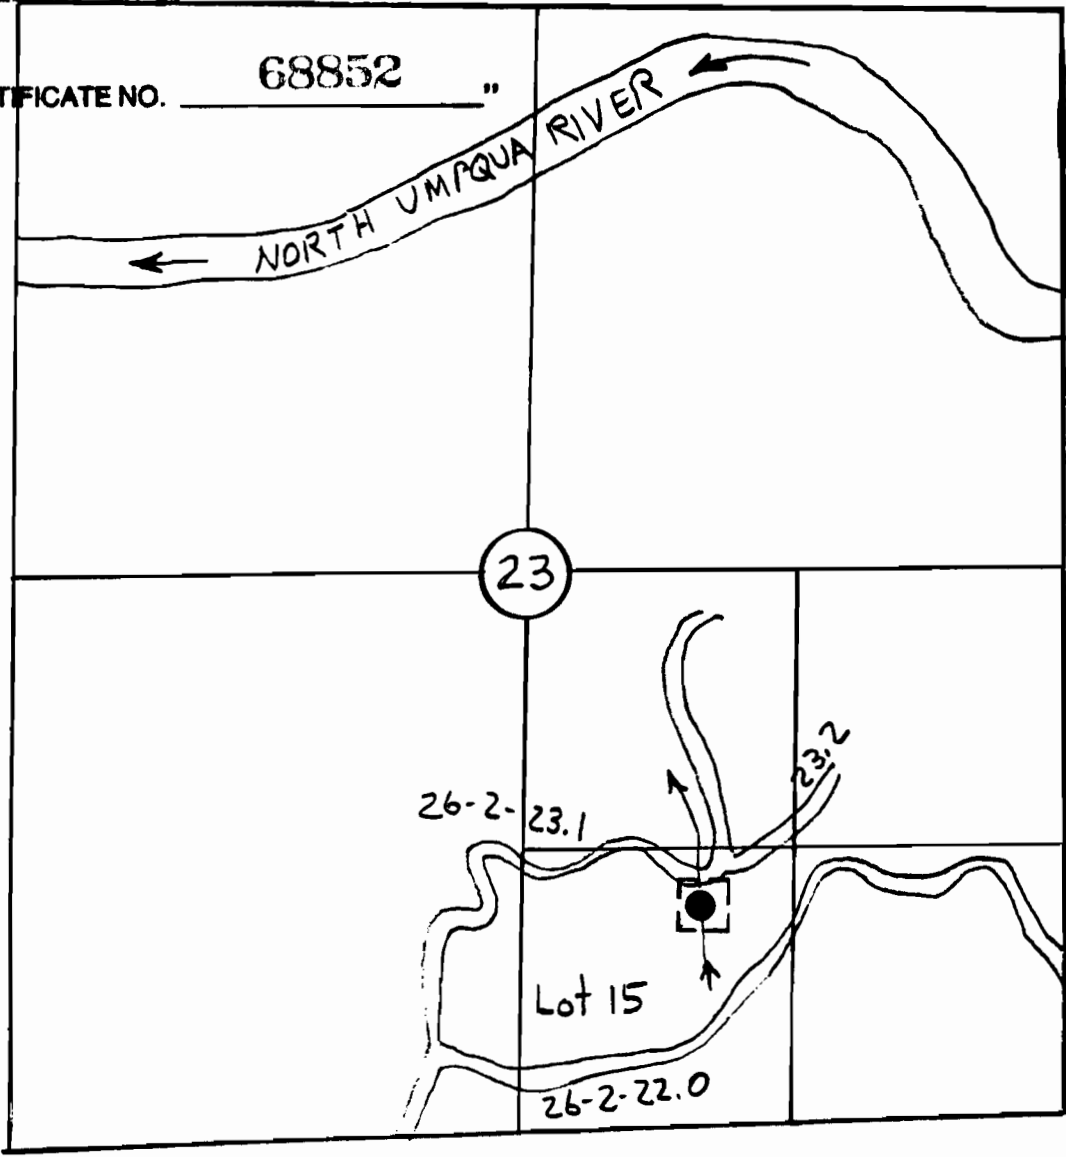


Scale 1"=1000'

SOUTH SIDE
T26S R2W Sec 23
Lot 15

The point of diversion is located approximately 1050 ft North and 1850 ft West from the Southeast Section corner of Section 23.

Coordinate Ties are based on aerial photo

The map is shown for the purpose of water application and not property boundary.

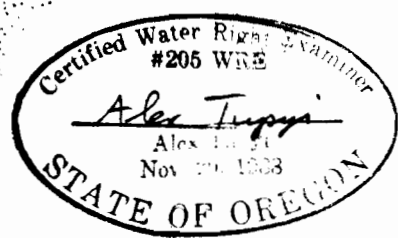

9-17-92