


Application No. 72762

FINAL PROOF MAP

Permit No. 68853
"CERTIFICATE NO."

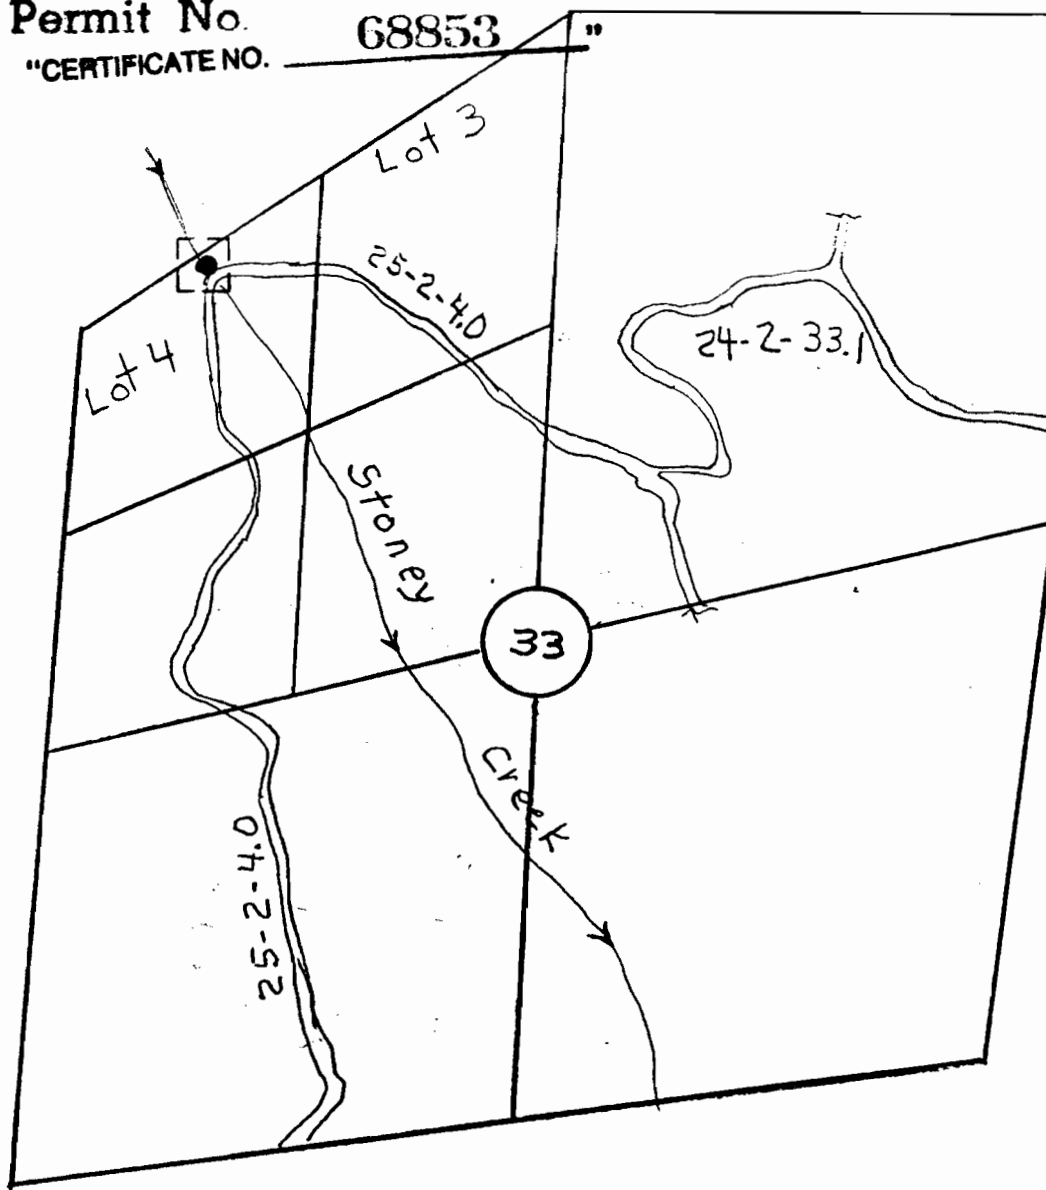


Scale 1" = 1000'

STAAB'S POND
T24S R2W Sec 33
Lot 4

The point of diversion is located approximately 350 feet North and 600 feet East from the Northwest Section Corner of Section 33.

Coordinate Ties are based on aerial photo 843A40.

This map is shown for the purpose of water application and not property boundary.

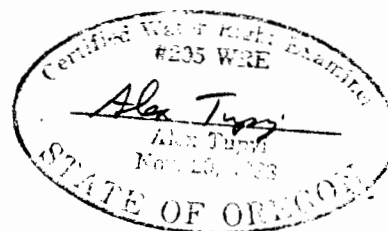

2-24-92