


Application No. 72768

Permit No. FINAL PROOF MAP
"CERTIFICATE NO. 68856"

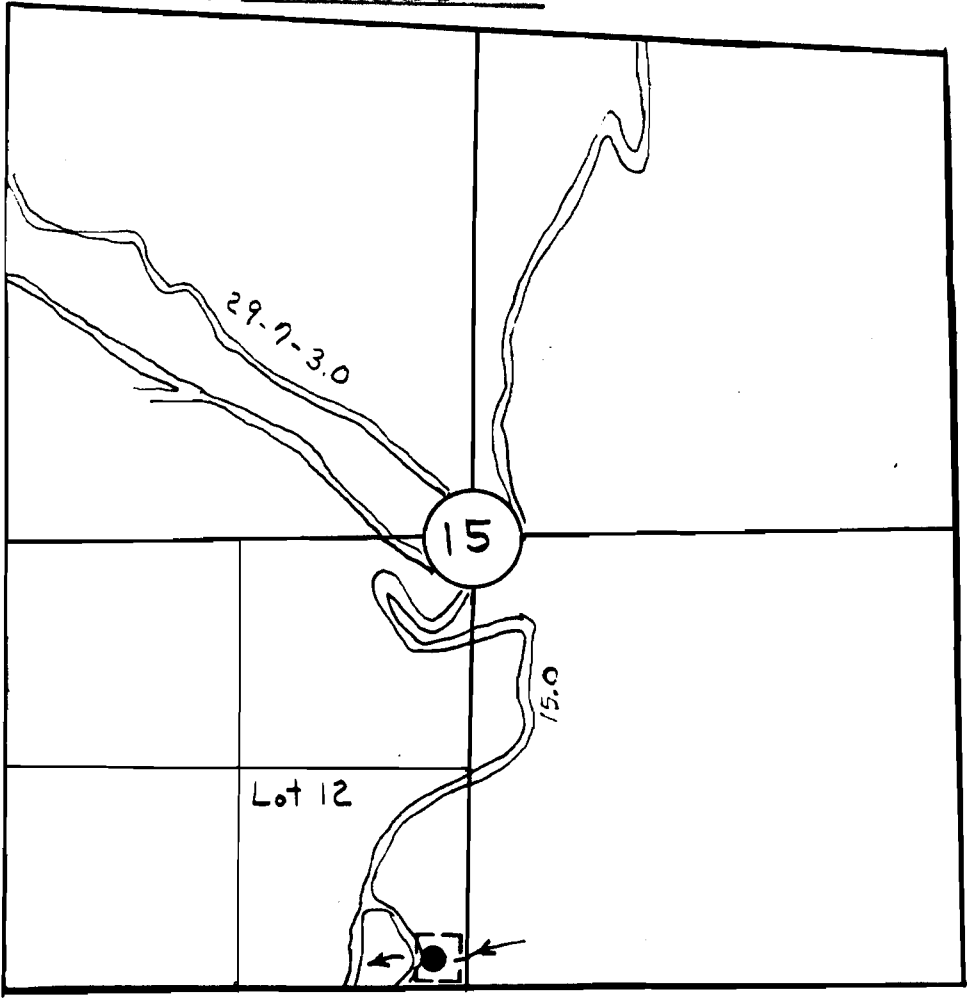

Scale 1"=1000'

FROG EYES PUMP CHANCE
T29S R7W Sec 15
Lot 12

The point of diversion is located approximately 100 ft North and 250 ft West from the South Quarter Corner of Section 15.

Coordinate Ties are based on aerial photo 10-14-34.

The map is shown for the purpose of water application and not property boundary.

Certified Water Right
#215 WRS
Alex Tuppi
Nov. 29, 1993
STATE OF OREGON
9-12-92