


FINAL PROOF MAP

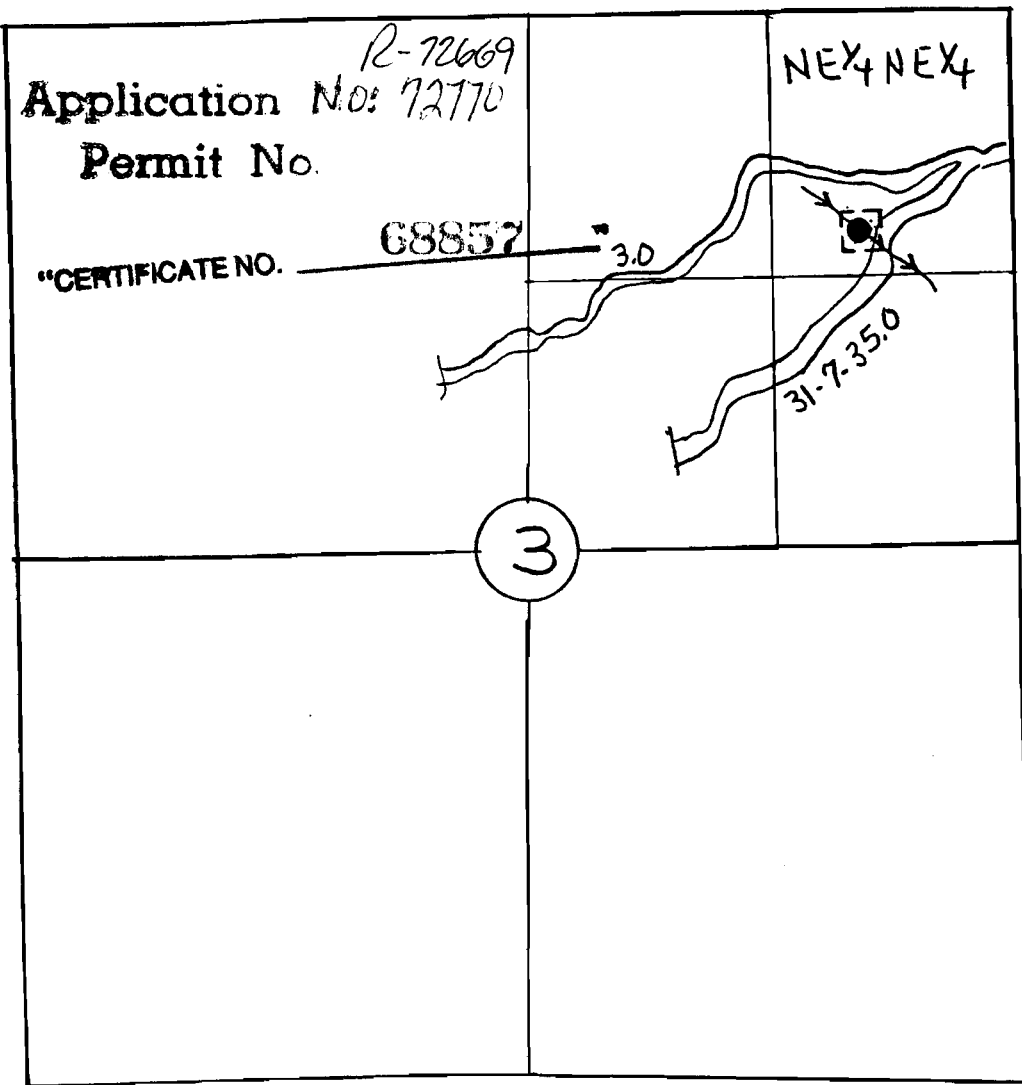


Scale 1"=1000'

BUCK CREEK PUMP CHANCE
T32S R7W Sec 3
NE $\frac{1}{4}$ NE $\frac{1}{4}$

The point of diversion is located approximately 1600 ft North and 700 ft West from the East Quarter Corner of Section 3.

Coordinate Ties are based on aerial photo 10-14-8.

The map is shown for the purpose of water application and not property boundary.

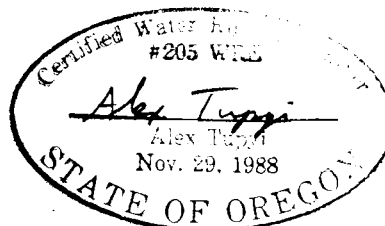

9-17-92