
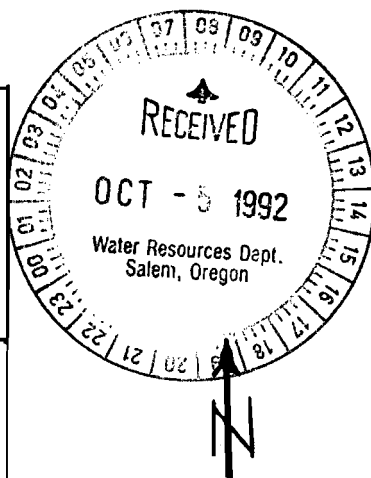


Application No. 72774 & R-72773
FINAL PROOF MAP

Permit No. 68859

"CERTIFICATE NO."

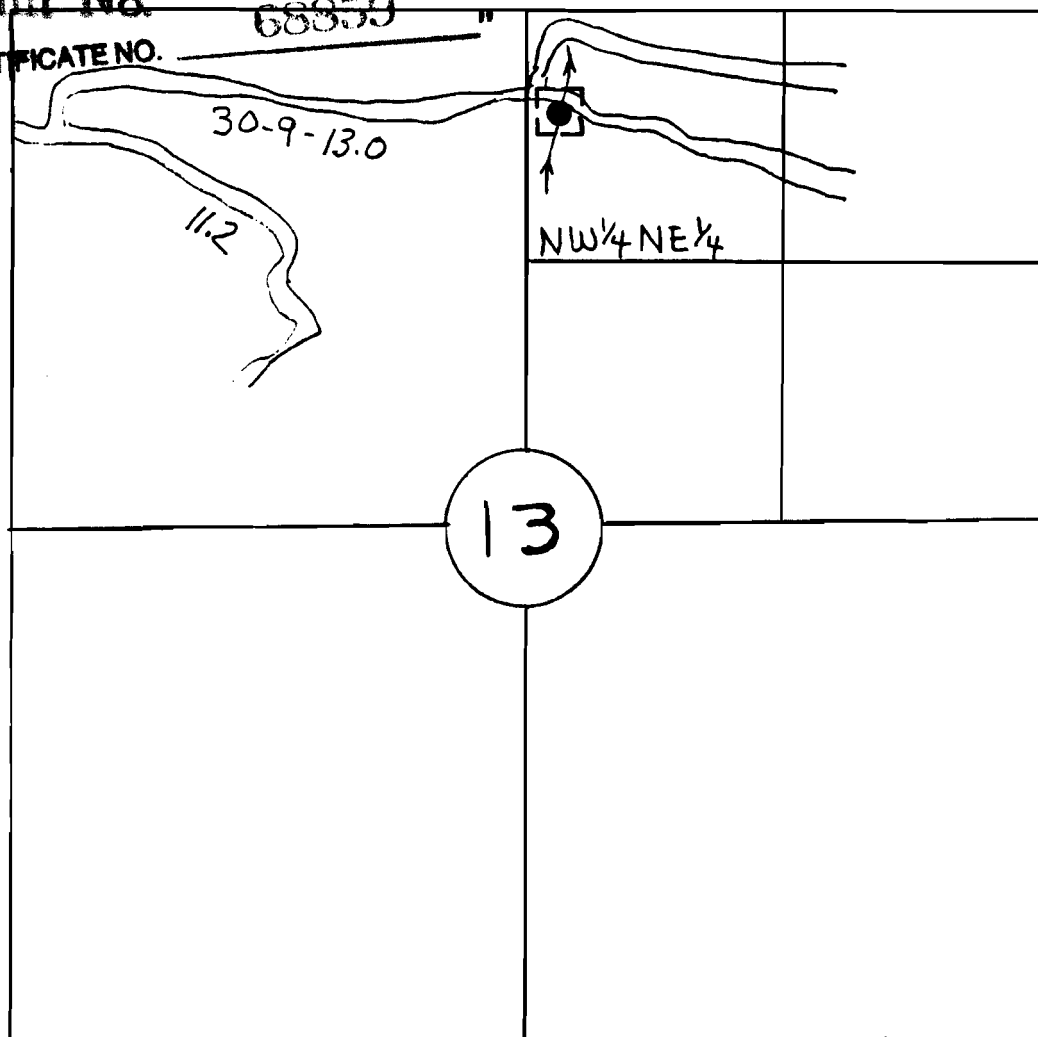


Scale 1" = 1000'

McPUDDLE
T30S R9W Sec 13
NW 1/4 NE 1/4

The point of diversion is located approximately 550 ft South and 200 ft East from the North Quarter Corner of Section 13.

Coordinate Ties are based on aerial photo 2-4-10.

The map is shown for the purpose of water application and not property boundary.

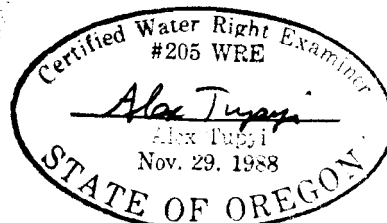

9-17-92