


Application No. 72776
Permit No. _____
FINAL PROOF MAP

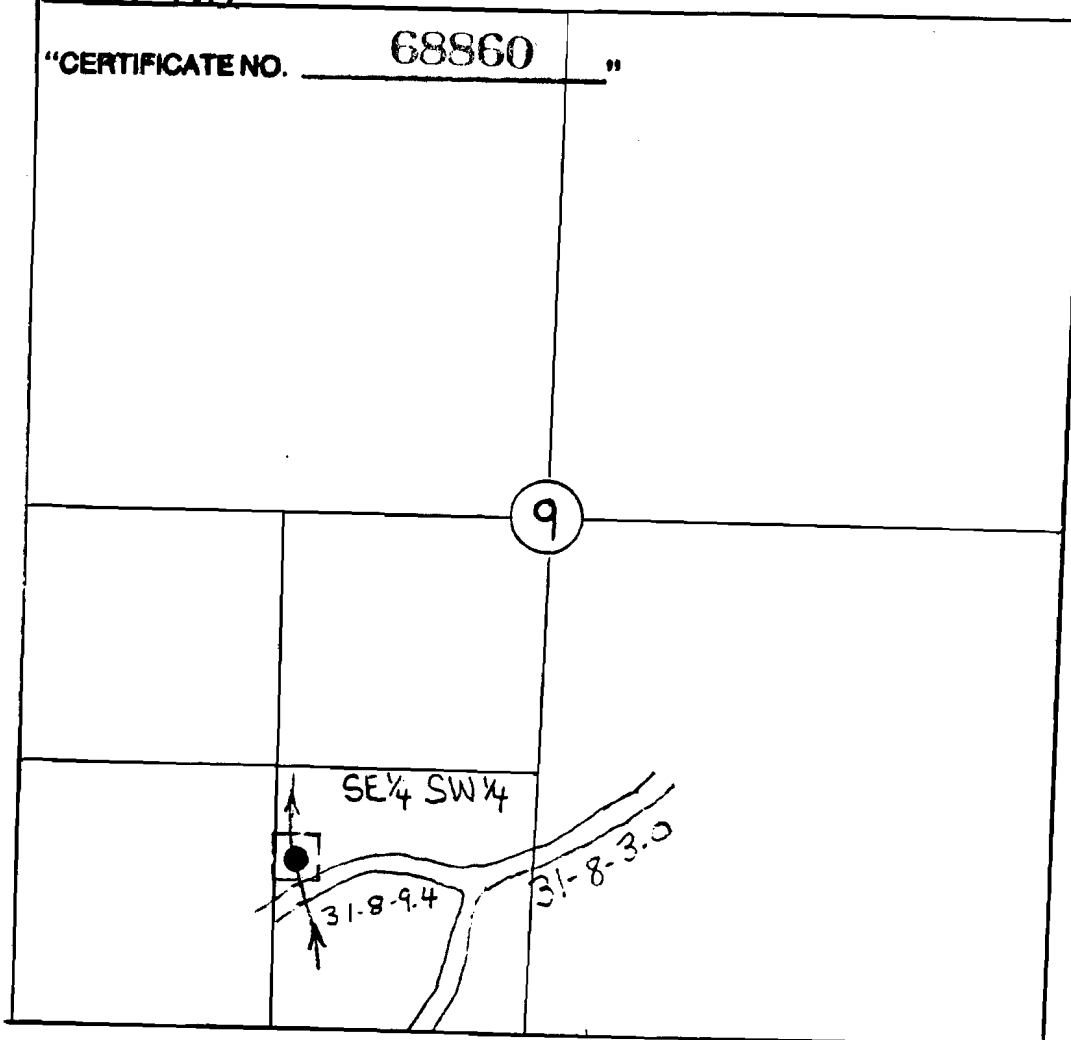


DUTCHMAN
T31S R8W Sec 9
SE $\frac{1}{4}$ SW $\frac{1}{4}$


The point of diversion is located approximately 800 ft North and 1400 ft East from the Southwest Section Corner of Section 9.

Coordinate Ties are based on aerial photo 3-7-13.

The map is shown for the purpose of water application and not property boundary.

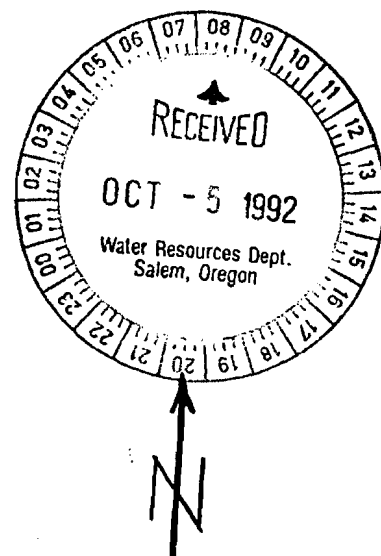

Scale 1" = 1000'

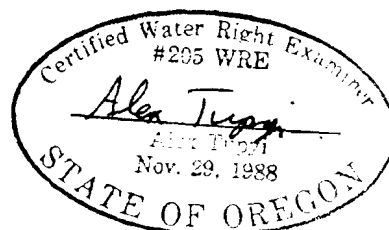

9-17-92