

RECEIVED

AUG 3 - 1979



WATER RESOURCES DEPT
SALEM, OREGON

Application No. 72871

Permit No.

T. 17 S. R. 40 E. W.M

CERTIFICATE NO. 68864

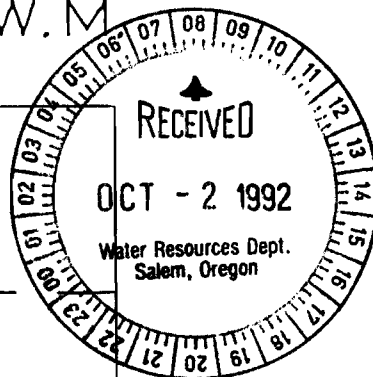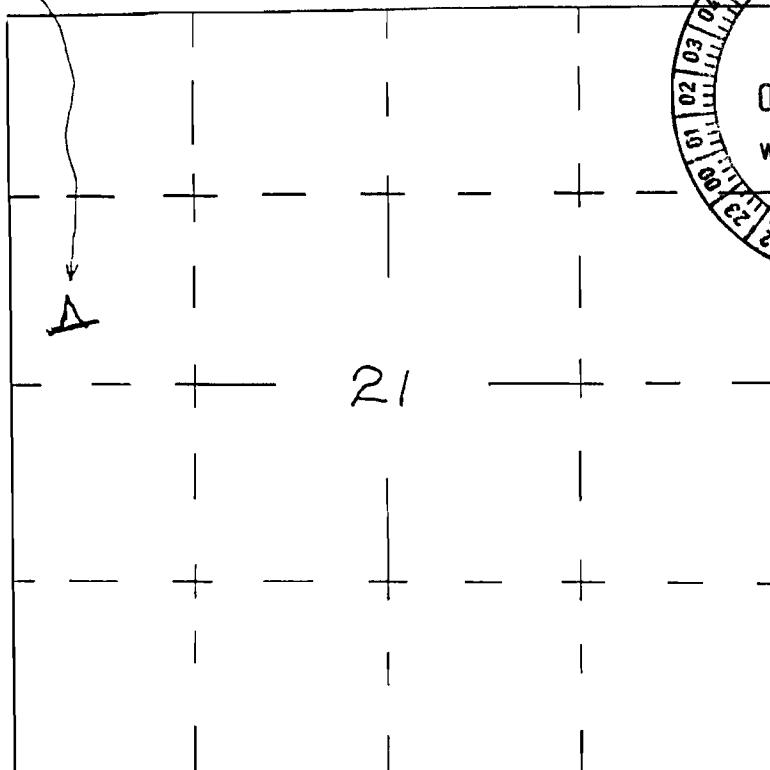

Application No. R59068

Permit No. R 8713

U. S. DEPARTMENT OF THE INTERIOR
BUREAU OF LAND MANAGEMENT

SADDLE

DESIGNED _____	RECOMM. _____
DRAWN _____	RECOMM. _____
CHECKED _____	APPROVED _____

CHIEF, DIV. OF ENO.

SCALE

DATE

SHEET _____ OF _____

DRAWING NO.