

Application No. R-72874

Form APL 87

March 1966

Permit No.

CERTIFICATE NO.

68867

UNITED STATES

DEPARTMENT OF THE INTERIOR

BUREAU OF LAND MANAGEMENT

SECTION

19



Oregon State Water Filings

NE SW

TOWNSHIP 21^S, RANGE 40^E, W. M.

North

Gold Cr.

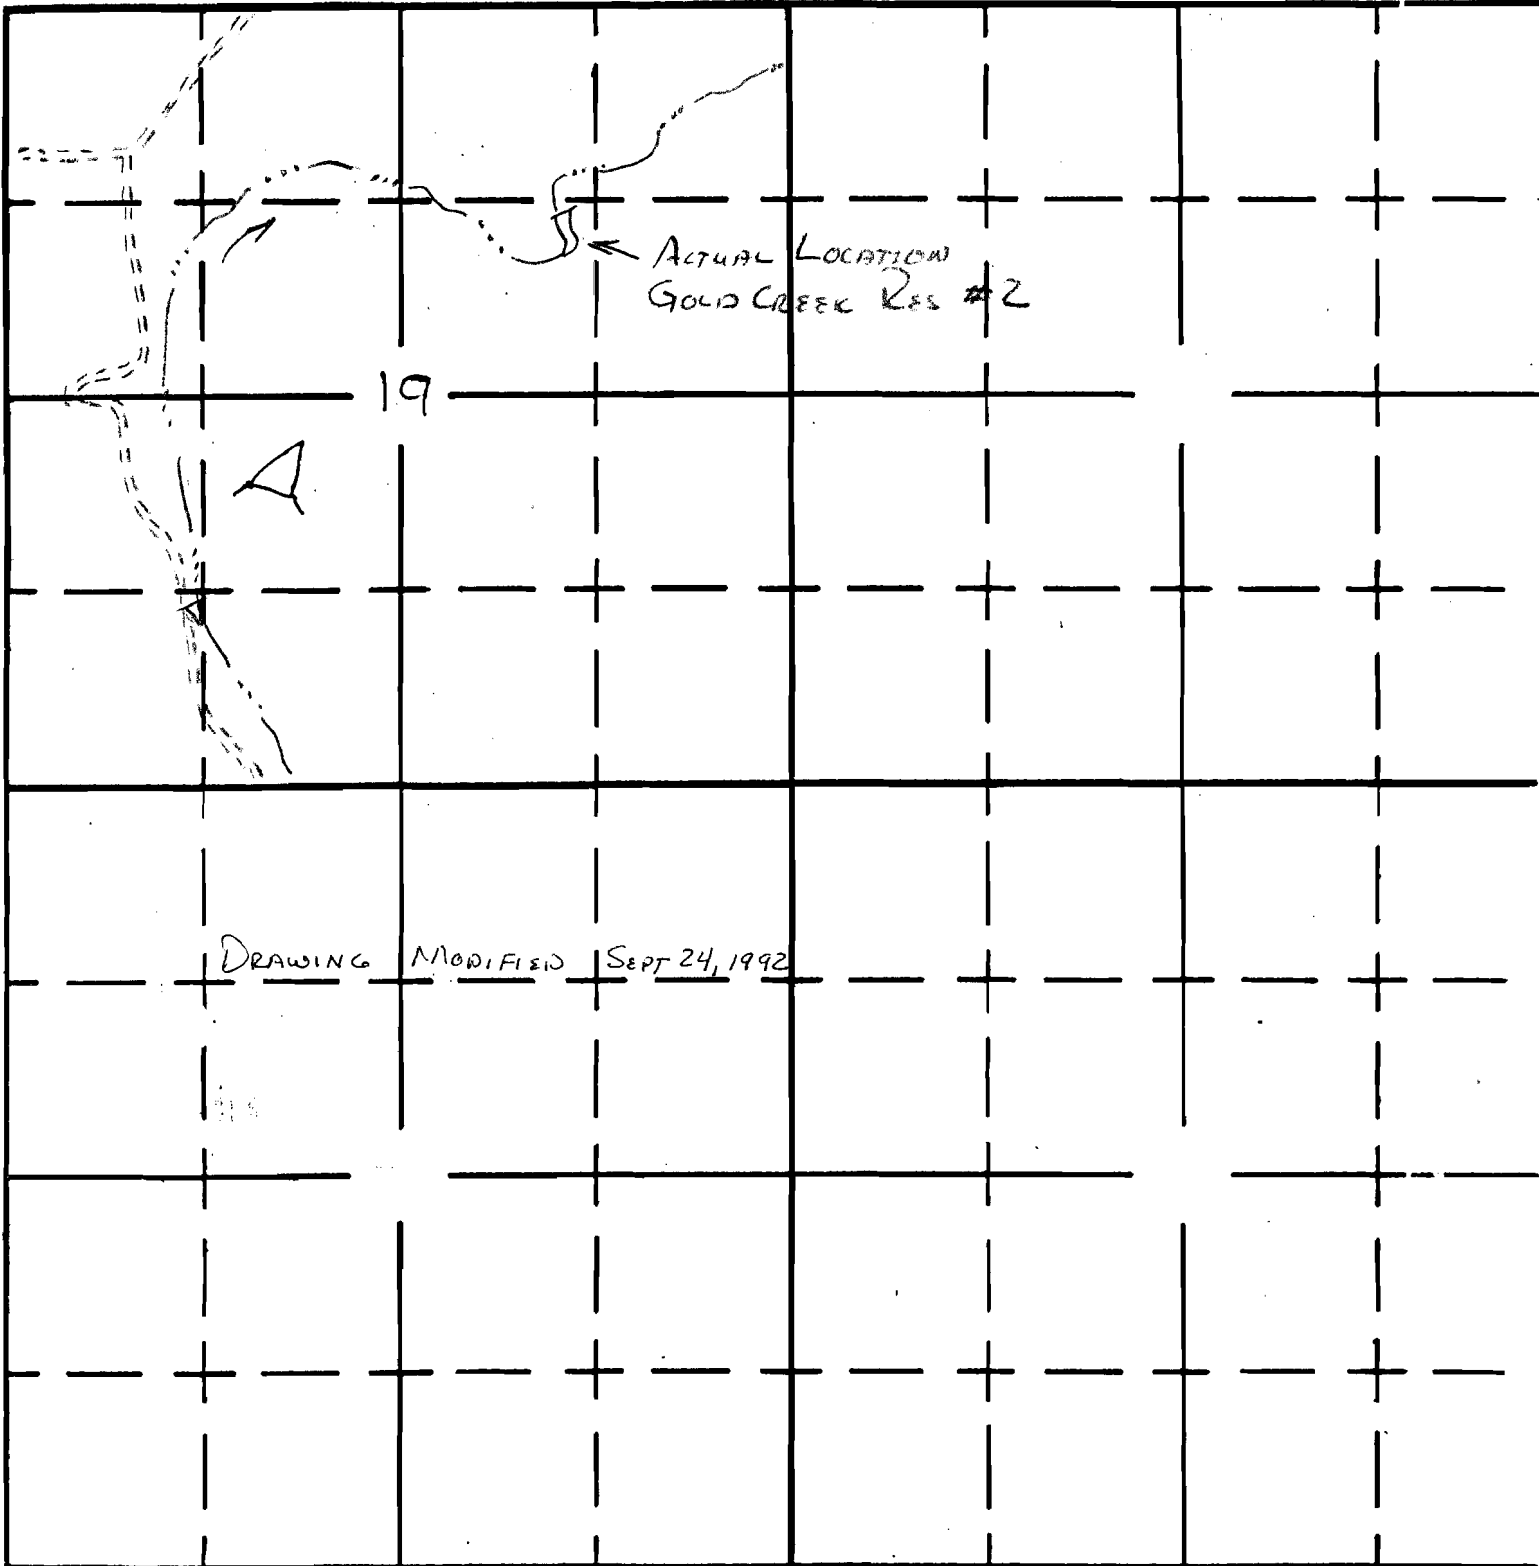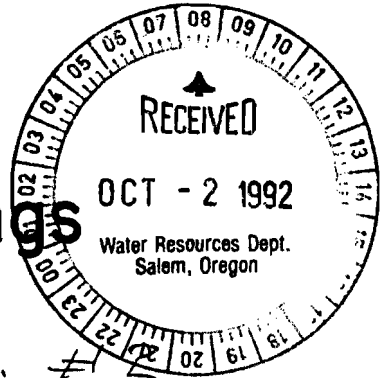

DRAWING MODIFIED SEPT 24, 1992

APPLICATION No. 394