

Application No. R-72992

Permit No.


CERTIFICATE NO. 68870

SEC. 32, T.17S.,
R. 24 E., W.M.



SCALE
1"=1320'

PROJECTED SECTION
CORNER

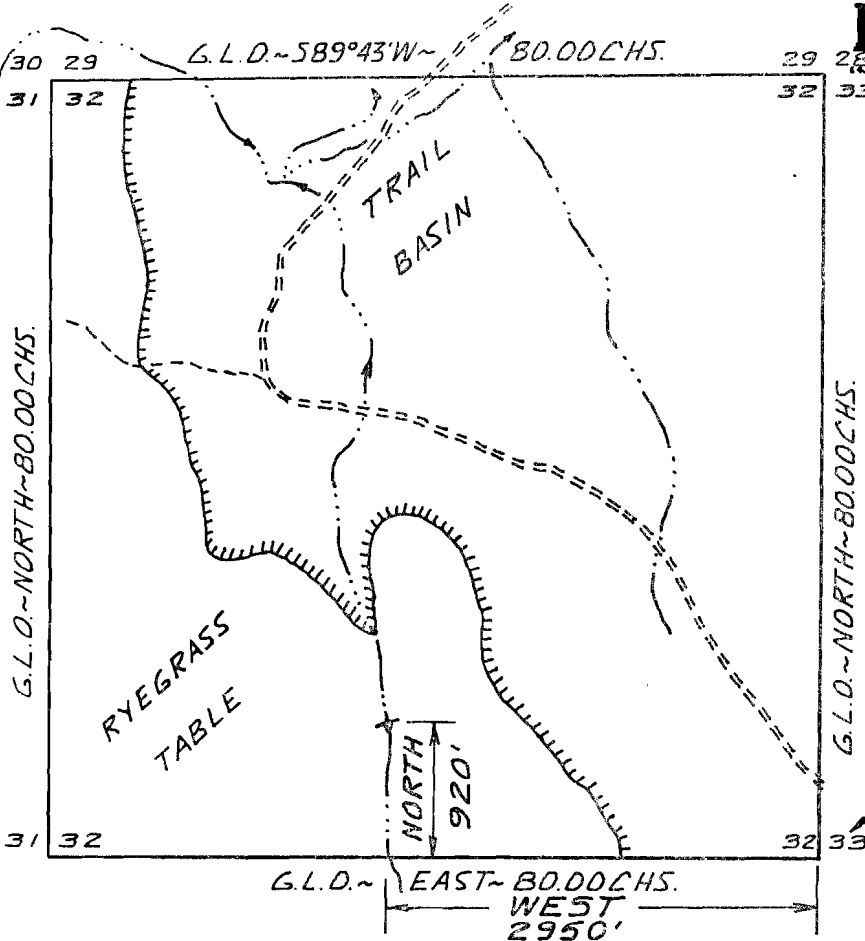

RESERVOIR LOCATION

LOCATED IN THE SE 1/4 SW 1/4 OF
SECTION 32, T.17S., R. 24 E., W.M.,
CROOK COUNTY, OREGON.

LOCATED 2950 FEET WEST AND
920 FEET NORTH OF THE S.E.
CORNER OF SECTION 32.

"SMOKEY RESERVOIR #4641"

LEGEND

- PROPOSED RESERVOIR SITE
- DRAINAGE
- == ROAD
- * WIRE FENCE
- |||| RIM ROCK

LOCATION SOURCE
U.S.G.S. QUADRANGLES,
MAUPIN BUTTE, OREG.,
7.5 MIN., 1981 AND ANGELL
BUTTE, OREG., 7.5 MIN.,
1981.


PREPARED FOR

U.S.D.I., BUREAU OF LAND
MANAGEMENT
PRINEVILLE DISTRICT
JAMES HANCOCK, MANAGER
P.O. BOX 550
PRINEVILLE, OREGON 97754
(503) 447-4115

NOTE

THE PREPARATION OF THIS MAP IS FOR THE
PURPOSE OF IDENTIFYING THE LOCATION OF THE
WATER RIGHT ONLY AND HAS NO INTENT TO
PROVIDE DIMENSIONS OR LOCATIONS OF
PROPERTY OWNERSHIP LINES.

ARMSTRONG SURVEYING
& ENGINEERING, INC.
378 EAST SECOND STREET
PRINEVILLE, OREGON 97754
(503) 447-7791

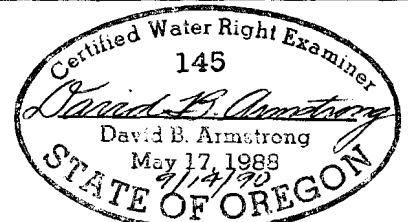

SCALE: 1"= 1320'

DATE: SEPT. 12, 1990

W.O. 90-750-D