


Application No. 2-72944

Permit No.

CERTIFICATE NO. 68872



SCALE  
1"=1320'

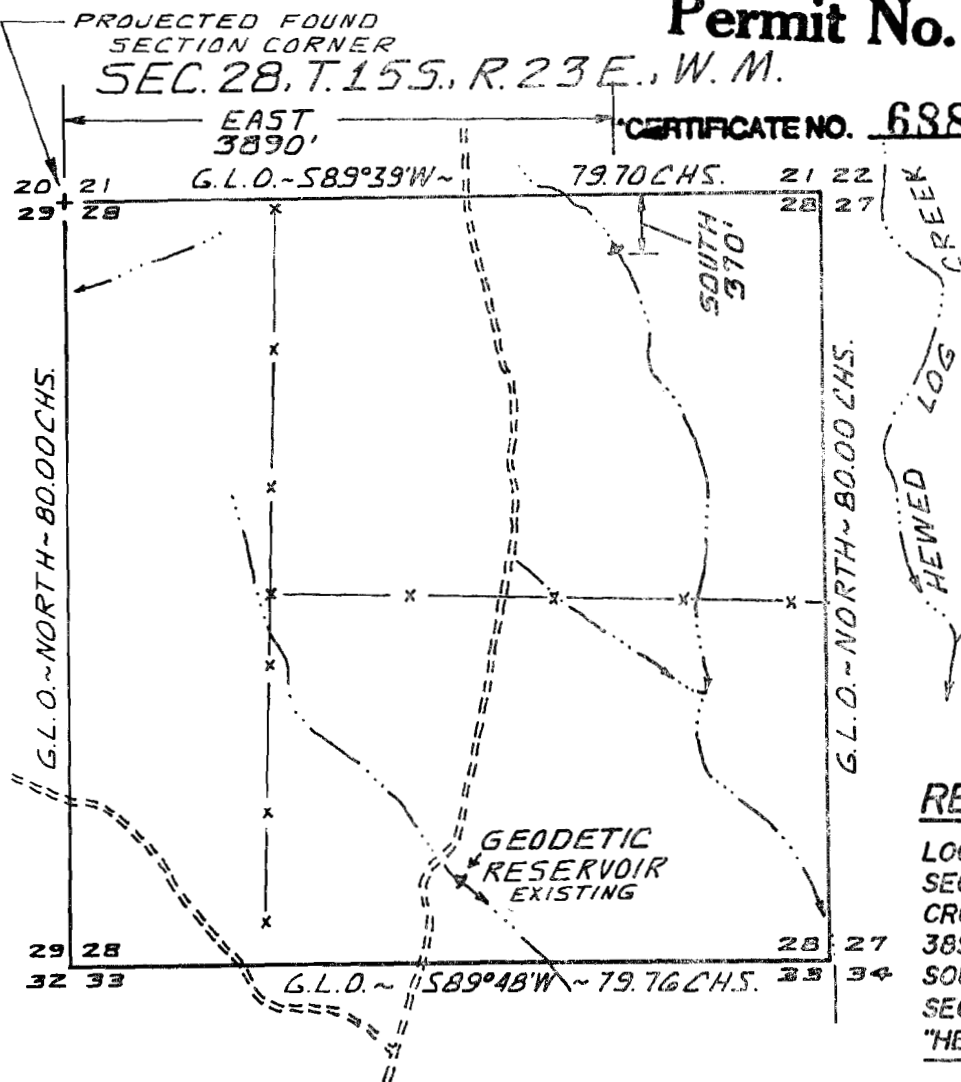

### RESERVOIR LOCATION

LOCATED IN THE NW1/4 NE1/4 OF SECTION 28, T. 15 S., R. 23 E., W.M., CROOK COUNTY, OREGON. LOCATED 3890 FEET EAST AND 370 FEET SOUTH OF THE N.W. CORNER OF SECTION 28.  
"HEWED LOG RESERVOIR, #4677"

### LOCATION SOURCE

U.S.G.S. QUADRANGLE, PAULINA, OREG.,  
7.5 MIN., 1981.

### PREPARED FOR

U.S.D.I., BUREAU OF LAND  
MANAGEMENT  
PRINEVILLE DISTRICT  
JAMES HANCOCK, MANAGER  
P.O. BOX 550  
PRINEVILLE, OREGON 97754  
(503) 447-4115


### NOTE

THE PREPARATION OF THIS MAP IS FOR THE PURPOSE OF IDENTIFYING THE LOCATION OF THE WATER RIGHT ONLY AND HAS NO INTENT TO PROVIDE DIMENSIONS OR LOCATIONS OF PROPERTY OWNERSHIP LINES.

### LEGEND

- ◄— PROPOSED RESERVOIR SITE.
- · — · — DRAINAGE
- X — WIRE FENCE
- ===== ROAD.

ARMSTRONG SURVEYING  
& ENGINEERING, INC.  
378 EAST SECOND STREET  
PRINEVILLE, OREGON 97754  
(503) 447-7791

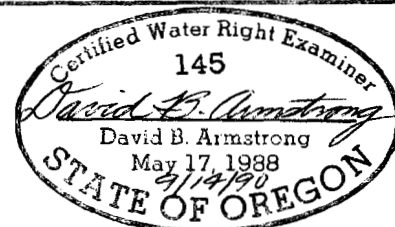

SCALE: 1"=1320'

DATE: SEPT. 12, 1990

W.O. 90-750-C