


Application No. ^{R-71860}
Permit No.

"CERTIFICATE NO. 68876"

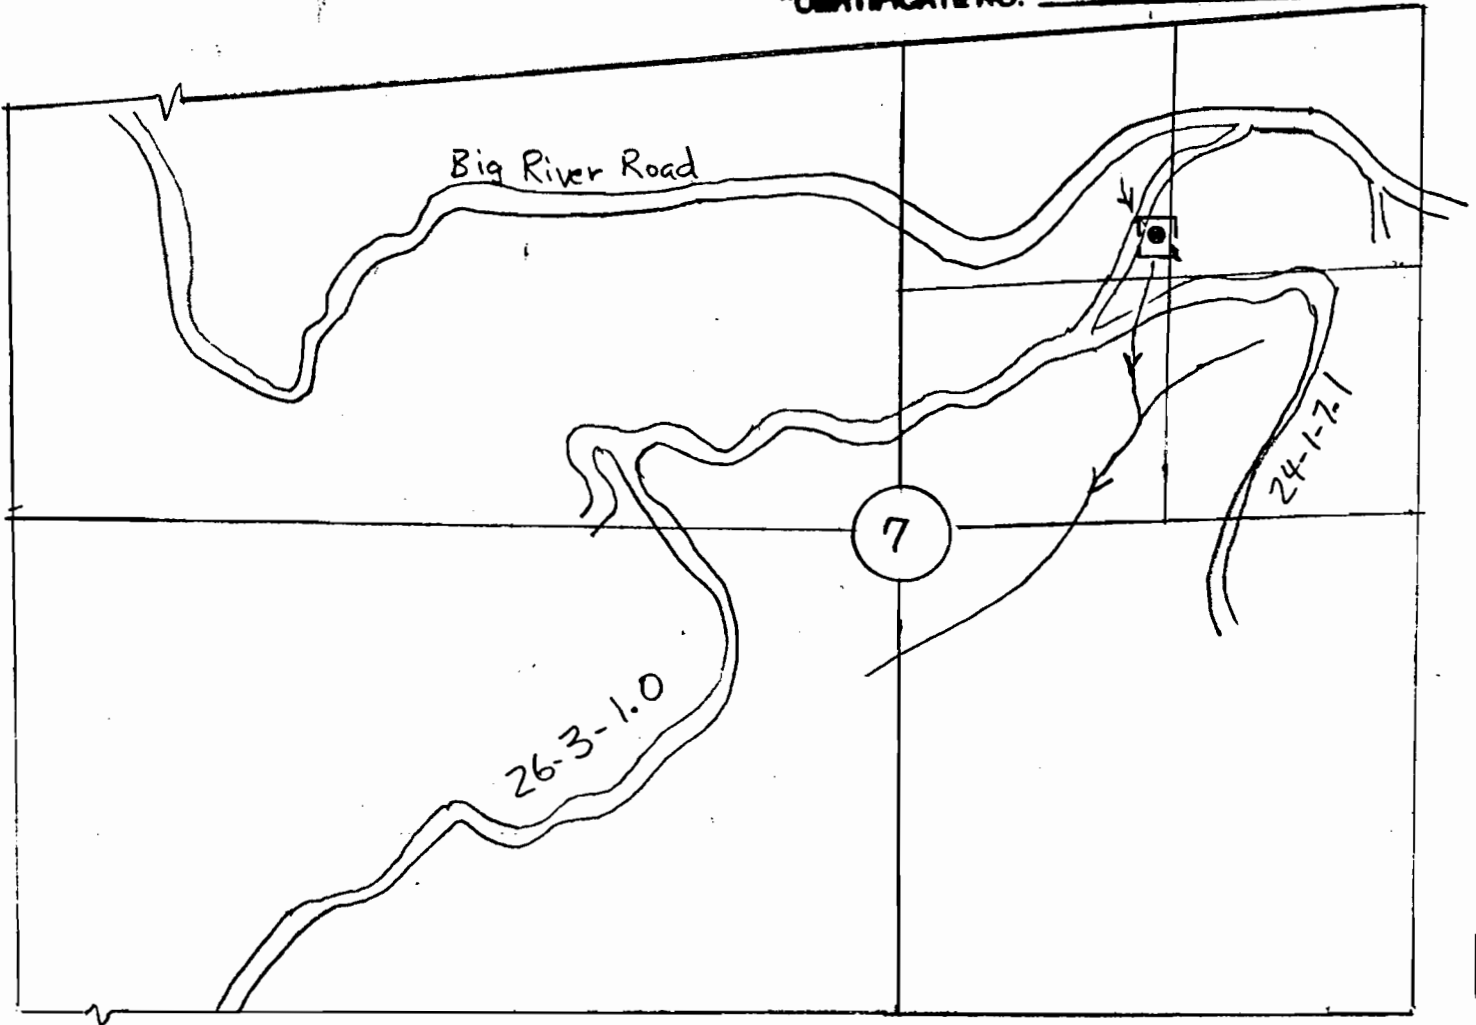


Scale 1" = 1000'

Ridge Top Pond
T24S R1W Sec7
NW $\frac{1}{4}$, NE $\frac{1}{4}$

The point of diversion is located approximately 1100 feet South and 1400 feet West from the Northeast Section Corner of Section 7.

Coordinate Ties are based on aerial photo 9-47-37.

The map is shown for the purpose of water application and not property boundary.

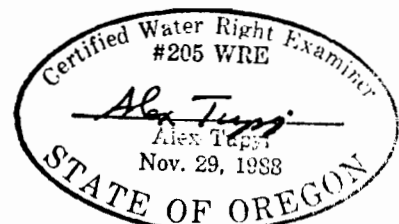

7-9-91