


"CERTIFICATE NO. 68880"

FINAL PROOF MAP

Application No. R-71862
Permit No.

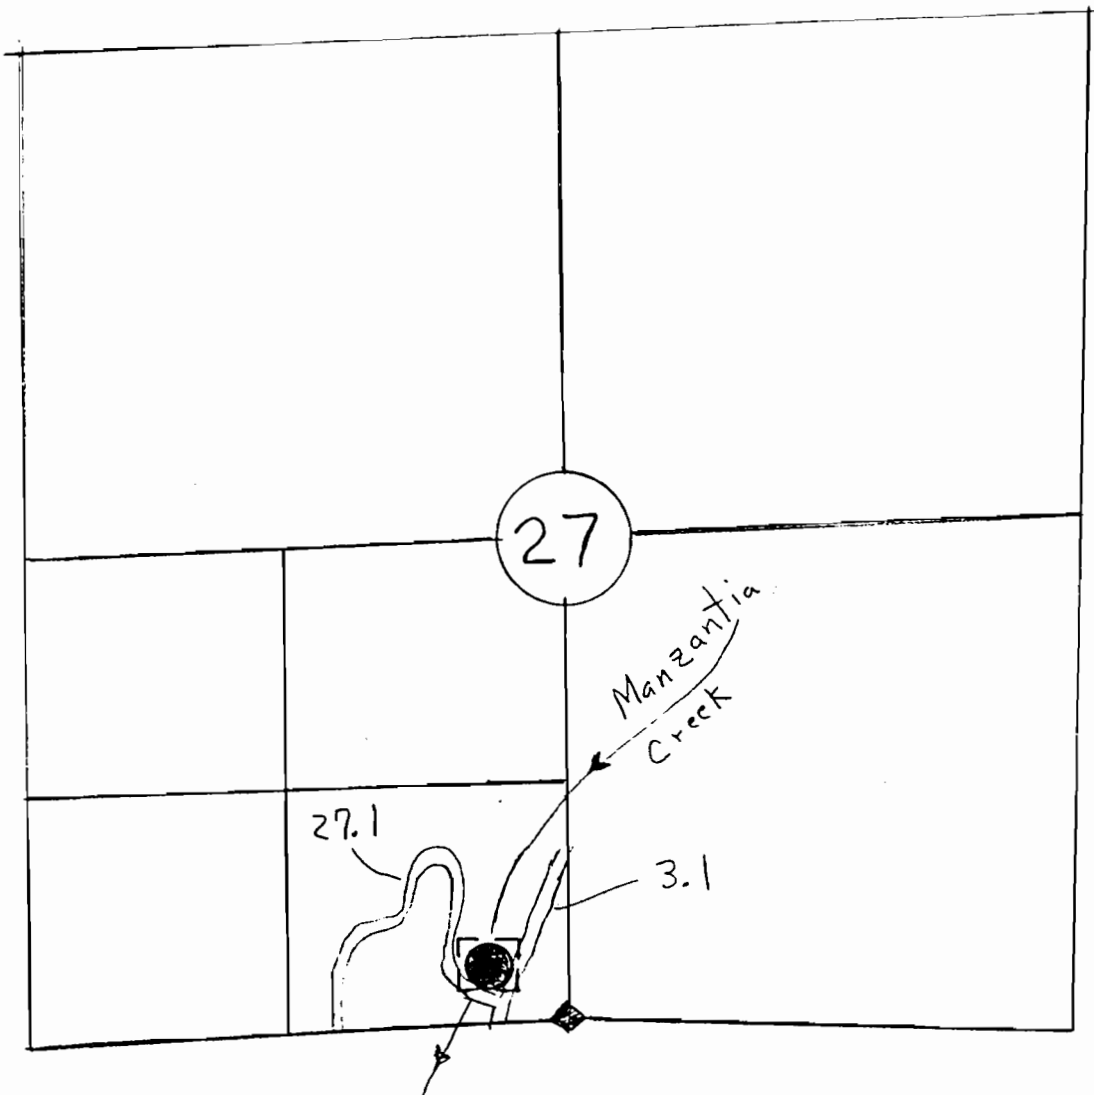


Scale 1" = 1000'

MANZANITA CREEK PUMP CHANCE
T30S R8W Sec 27
SE $\frac{1}{4}$ SW $\frac{1}{4}$

The point of diversion is located 300 ft North and 300 ft West from the South Quarter Corner of Section 27.

Coordinate Ties are based on aerial photo 3-8-17-89.

The map is shown for the purpose of water application and not property boundary.

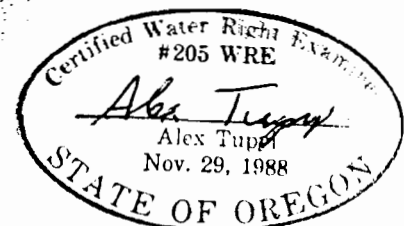

3-5-90