


"CERTIFICATE NO. 68883"

R 38 E

R 39 E

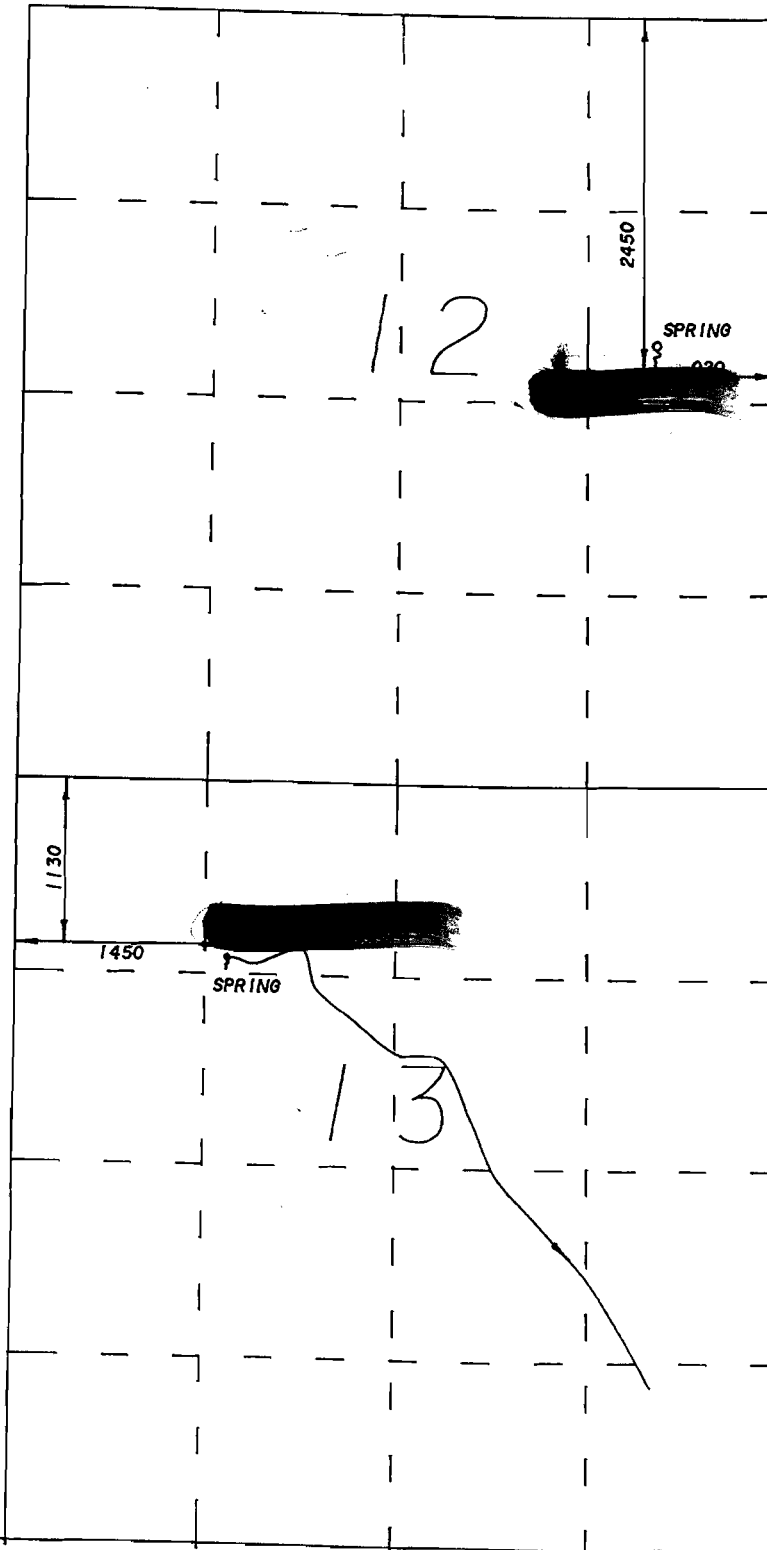

APPLICATION