


**FINAL PROOF SURVEY MAP
IN THE NAME OF DONALD C. PATSTON**


APPLICATION S - 73133

PERMIT 53150

SECTION 27, TOWNSHIP 26 SOUTH, RANGE 6 WEST, W.M.

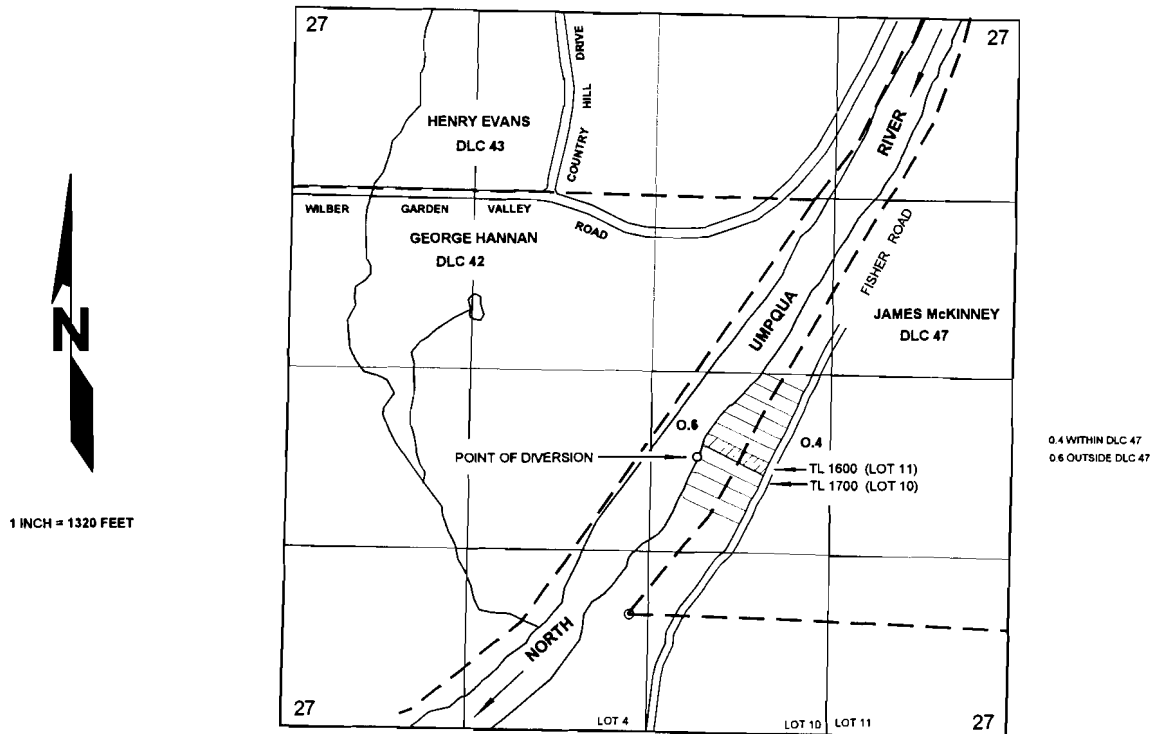

THE POINT OF DIVERSION IS LOCATED 1945 FEET NORTH AND 2120 FEET WEST FROM THE SOUTHEAST CORNER OF SECTION 27; BEING WITHIN THE NW $\frac{1}{4}$ SE $\frac{1}{4}$ OF SECTION 27, TOWNSHIP 26 SOUTH, RANGE 6 WEST, W.M.; DOUGLAS COUNTY.

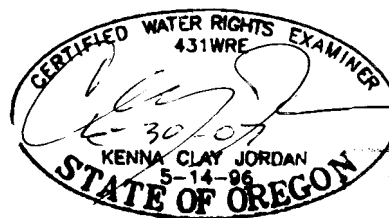

RECEIVED

AUG 16 2006

WATER RIGHTS DEPT
SALEM, OREGON